



OFFICE OF THE
DOUGLAS COUNTY SURVEYOR

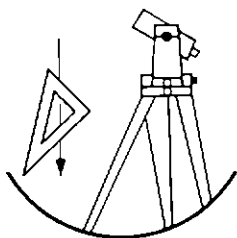

Station: X-9
Date Set: 1920
Set By (Agency): USC&GS
DCSO Designation: X-001
Date Recovered: 6-22-84
Recovered By: _____
Date Recovered: _____
Recovered By: _____
Date Recovered: _____
Recovered By: _____

T28W R6W Sec. 11

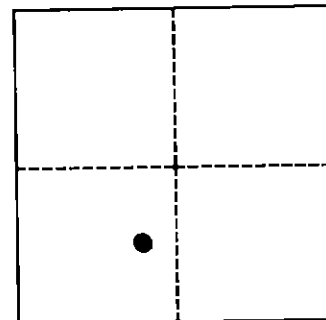

VERTICAL CONTROL


NGVD 29 Elevation: 512.282 FEET NAVD 88 Elevation: 157.205 METERS
NGS Line # 6 USGS LINE # _____ OSHD Line # _____ FILE # _____
Precision: 1ST ORDER Agency: USC&GS Proj: _____ Date: 1957

HORIZONTAL CONTROL

O.C.S. 27 Y(Northing): _____ O.C.S. 83 Y(Northing): _____
(South Zone) X(Easting): _____ (South Zone) X(Easting): _____
Precision: _____ Agency: _____ Proj: _____ Date: _____
Approx. O.C.S. 27 Geographic Position: Latitude: 43°08'45" Longitude: 123°22'29"
Approx. O.C.S. 83 Geographic Position: Latitude: _____ Longitude: _____

Description: A USC&GS disk stamped "ELEV. 511.662 FT X-9 1920" set in the northeast corner of a Southern Pacific Railway concrete bridge curb (Roberts Creek crossing).

To reach: From the intersection of State Hwy 99 and Winery Lane in T28S R6W Sec11 proceed southerly along Winery Lane approx. 0.2 miles to a sharp left hand corner. Monument lies 50 feet on the right.

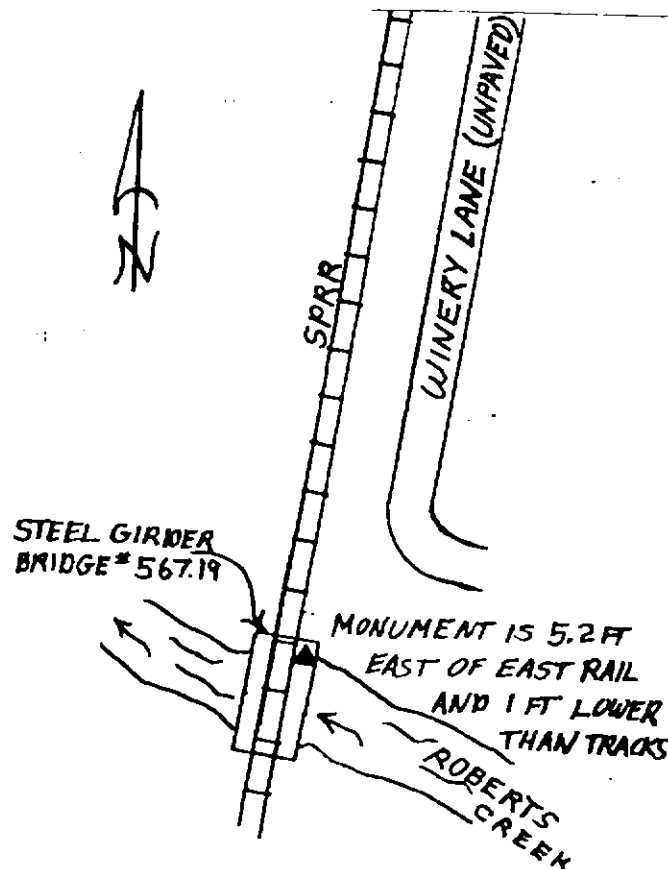

Note: For further information contact the Douglas County Surveyors Office, Room 205 Douglas County Justice Building, Roseburg, OR 97470. Phone 440-4272. Douglas County Residents outside Roseburg calling area, dial toll free 1-800-477-0991.