



OFFICE OF THE
DOUGLAS COUNTY SURVEYOR

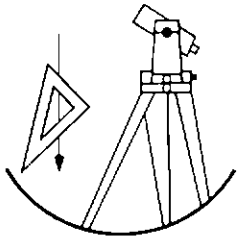

Station: A 741X
Date Set: 1987
Set By (Agency): NGS
DCSO Designation: A-083
Date Recovered: 8-93
Recovered By: SJE RWS
Date Recovered: _____
Recovered By: _____
Date Recovered: _____
Recovered By: _____

T28W R6W Sec. 15

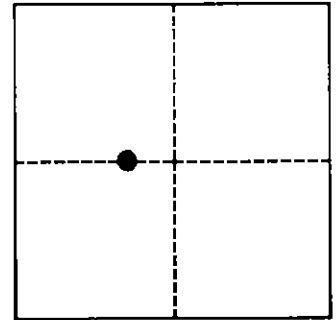

VERTICAL CONTROL


NGVD 29 Elevation: _____ FEET NAVD 88 Elevation: 151.222 METERS
NGS Line # 125035 USGS LINE # _____ OSHD Line # _____ FILE # _____
Precision: 1ST ORDER Agency: NGS Proj: _____ Date: 1988

HORIZONTAL CONTROL

O.C.S. 27 Y(Northing): _____ O.C.S. 83 Y(Northing): _____
(South Zone) X(Easting): _____ (South Zone) X(Easting): _____
Precision: _____ Agency: _____ Proj: _____ Date: _____
Approx. O.C.S. 27 Geographic Position: Latitude: 43°08'01" Longitude: 123°23'55"
Approx. O.C.S. 83 Geographic Position: Latitude: _____ Longitude: _____

Found: A 3 - 5/8 inch diameter NGS disk stamped "A 741X 1987" set vertically in the Northeast face of the Southwest concrete abutment of the Southwest bound lanes of bridge over South Umpqua River.

To reach: Go to the State Hwy. 99 and 42 bridge over the South Umpqua River in T28S R6W Sec15.

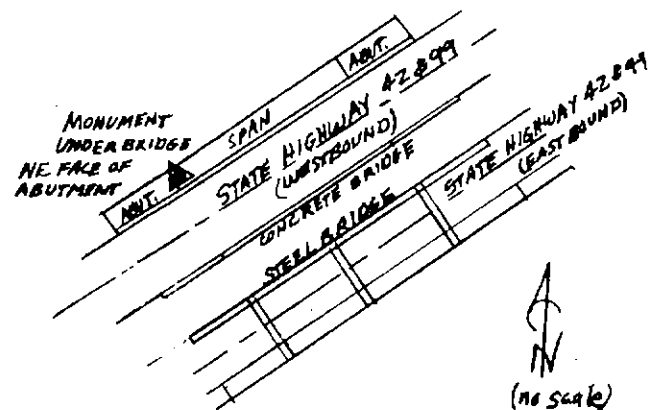

Note: For further information contact the Douglas County Surveyors Office, Room 205 Douglas County Justice Building, Roseburg, OR 97470. Phone 440-4272. Douglas County Residents outside Roseburg calling area, dial toll free 1-800-477-0991.