


OFFICE OF THE
DOUGLAS COUNTY SURVEYOR

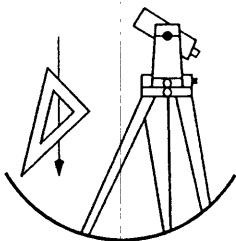

Station: K 741X

T28S R6W Sec. 21

Date Set: 1987

Set By (Agency): NGS

DCSO Designation: K-040

Date Recovered: 8-93


Recovered By: RWS S.JF

Date Recovered: _____

Recovered By: _____

Date Recovered: _____

Recovered By: _____

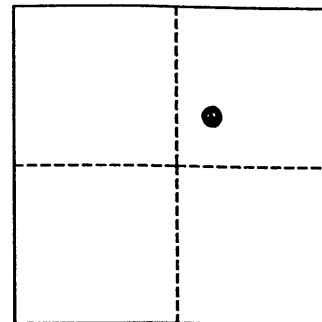

VERTICAL CONTROL

DCSO 2005 3RD ORDER

NGVD 29 Elevation: 534.80 FEET NAVD 88 Elevation: 164.062 METERS

NGS Line # 125034 USGS LINE # _____ OSHD Line # _____ FILE # CS 67/17

Precision: 1ST ORDER Agency: NGS Proj: _____ Date: 1988

HORIZONTAL CONTROL

O.C.S. 27 Y(Northing): _____ O.C.S. 83 Y(Northing): _____

(South Zone) X(Easting): _____ (South Zone) X(Easting): _____


Precision: _____ Agency: _____ Proj: _____ Date: _____

Approx. O.C.S. 27 Geographic Position: Latitude: 43°07'21" Longitude: 123°24'43"

Approx. O.C.S. 83 Geographic Position: Latitude: _____ Longitude: _____

Found: A 9/16 inch diameter stainless steel rod under a 6 - 5/8 inch diameter aluminum collar with access cover, set in concrete, flush with ground. Collar stamped "K 741X 1987".

To reach: Go to the intersection of State Hwy 42 and State Hwy 99 in T28S R6W Sec 21 (in Winston). Monument is northwest of intersection.

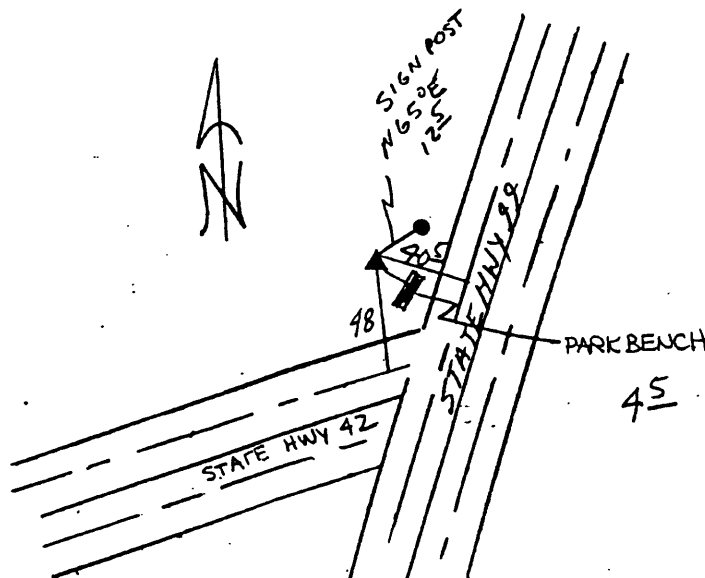

Note: For further information contact the Douglas County Surveyors Office, Room 205 Douglas County Justice Building, Roseburg, OR 97470. Phone 440-4272. Douglas County Residents outside Roseburg calling area, dial toll free 1-800-477-0991.