


OFFICE OF THE
DOUGLAS COUNTY SURVEYOR

Station: RICE T 28 S, R 6 W , Sec 29
Set By (Agency): Don Garrett
Date Set: 1972 RLS #0544
Recovered By RS, SJF
Date Recovered July 17, 1984
Recovered By _____
Date Recovered _____
Recovered By _____
Date Recovered _____

r-037 285 6W 29
RICE 1972

NAD 535853.87 4136095.85
83 43° 5'57" 123°26'26"

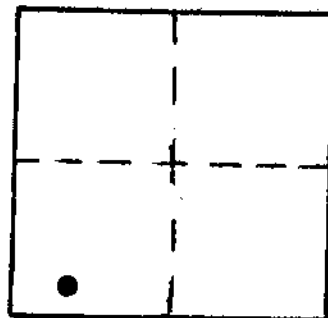

VERTICAL CONTROL NGVD 29

Elevation: 635.91 Ft. NGS Line # _____ USGS Line # _____ OSHD Line # _____
Precision: 3rd. Agency: Don Bentz Proj. # _____ Date: 1972
HORIZONTAL CONTROL OCS 27 RLS #0839

South Zone State Plane Coordinates: Y(Northing) 535,888.97 X(Easting) 1,215,137.62
Precision: 1/25,000 Agency: DCSO Proj. # 2005 CS 56/9 Date: 1972
Approximate Geographic Position: Latitude 43°05'58" Longitude 123°26'22"

DESCRIPTION and TO REACH


A D.C.S.O. disk stamped "RICE 1972" set on an iron pipe and flush with ground.

TO REACH:

From the intersection of Highway 42 (no scale) and the Brockway-Dillard Road (Co. Rd. #47) in T28S,R6W,Sec.29, proceed southerly along Brockway-Dillard Rd. approximately 0.9 miles to a private road on the right (road to Hill Top Acres Ranch; Rice & Kinnerly) proceed westerly along private road approx. 0.2 miles to top of ridge running southerly, proceed on foot southerly along ridge top approx. 500 feet, monument is approx. 175 feet off of ridge top on the east slope.

Reference Marks:

A D.C.S.O. disk stamped "RICE RM 1 1972" bears N69°11'36"W, 50.28 ft. (grid).

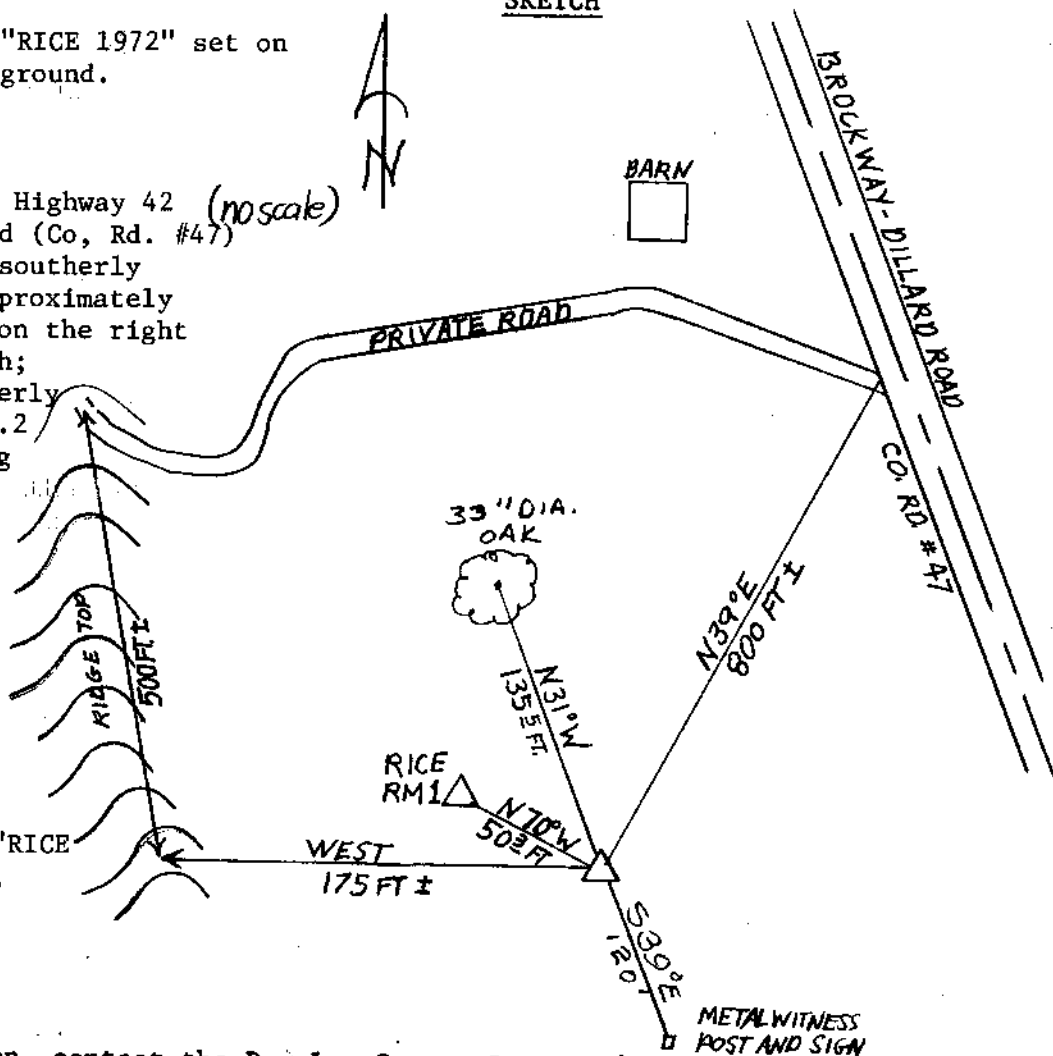

Note: For further information, contact the Douglas County Surveyor's Office, Room 205 Douglas County Justice Building, Roseburg, OR 97470. Phone 440-4278. Douglas County residents outside the Roseburg calling area, dial toll free 1-800-452-0991.