


OFFICE OF THE
DOUGLAS COUNTY SURVEYOR

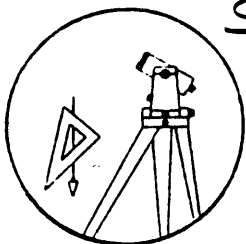

S-104

Station: SCR-7

T 28 S, R 7W, Sec 10


Date Set: JULY 1998

Set By (Agency): DCSO

Date Recovered: 7/27/98

Recovered By: _____

- | | |
|-------------------------------------|---|
| ☐ Found | ☒ New |
| ☐ Reset | ☐ Not Found |
| ☐ Referenced | ☐ Destroyed |

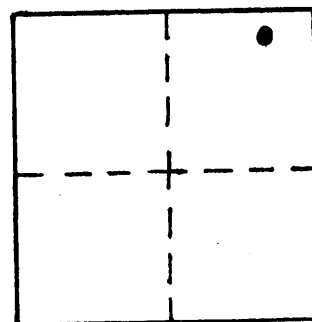

VERTICAL CONTROL NGVD 29

Elevation: 582.26 NGS Line # _____ USGS Line # _____ OSHD Line # _____

Precision: 3rd Agency: DCSO Proj. # 2007 Date: 1998

CS 66/49

HORIZONTAL CONTROL

South Zone O.C.S. 27: Y(Northing) _____ X(Easting) _____

South Zone O.C.S. 83: Y(Northing) _____ X(Easting) _____

Precision: _____ Agency: _____ Proj. # _____ Date: _____

Approx. NAD ~~83~~ ²⁷ Geographic Position: Latitude 43° 09' 20" Longitude 123° 30' 18"

DESCRIPTION and TO REACH

A DCSO DRILL CAP STAMPED "SCR-7 1998" SET
FLUSH IN TOP OF CONCRETE BOX CULVERT HEADWALL OF
CHANNELED STREAMBED RUNNING WEST TO EAST
FROM THE INTERSECTION OF STATE HIGHWAY 42 AND
STRICKLAND CANYON ROAD (CO. RD. #108) IN T28S, R7W, SEC 27
PROCEED EASTERLY AND NORTHERLY ALONG STRICKLAND CANYON
RD. APPROXIMATELY 4.5 MILES TO MONUMENT ON RIGHT.

Reference Marks:

