


OFFICE OF THE
DOUGLAS COUNTY SURVEYOR



#-101 29S 4W 19
2 HJH 801

NAD 507835.05 4194902.35
83 43° 1'40" 123°13' 2"

Station: 2 HJH 801 T 29 S, R 4W , Sec 19
Set By (Agency): USGS
Date Set: 1953
Recovered By KR, TP
Date Recovered 4-6-82
Recovered By 8/92 DCSO
Date Recovered _____
Recovered By _____
Date Recovered _____

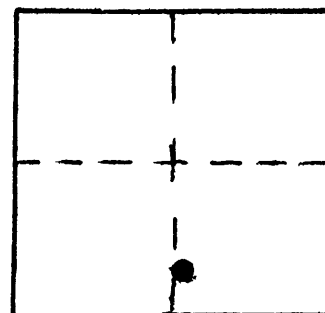

VERTICAL CONTROL NGVD 29

Elevation: 800.845 NGS Line # _____ USGS Line # 145 OSHD Line # _____
Precision: 2nd Order Agency: DCSO Proj. # _____ Date: 1992

HORIZONTAL CONTROL

South Zone State Plane Coordinates: Y(Northing) 507,870.73 X(Easting) 1,273,943.90
Precision: 1/25,000 Agency: DCSO Proj. # 2008 Date: 1992
Approximate Geographic Position: Latitude 43°01'40" Longitude 123°12'57"


DESCRIPTION and TO REACH

SKETCH

Found - A standard USGS disk set in concrete bell tile protruding 5" above ground. The disk has been hit by a mower, but is still intact; stamped "2HJH 801 1953".

To reach from the intersection of Co. Rd. 18 and Co. Rd. 18A, proceed Easterly along Co. Rd. 18 2.0 mi. to station on left. Above intersection is in T29S,R5W,Sec. 23.

Reference Marks:

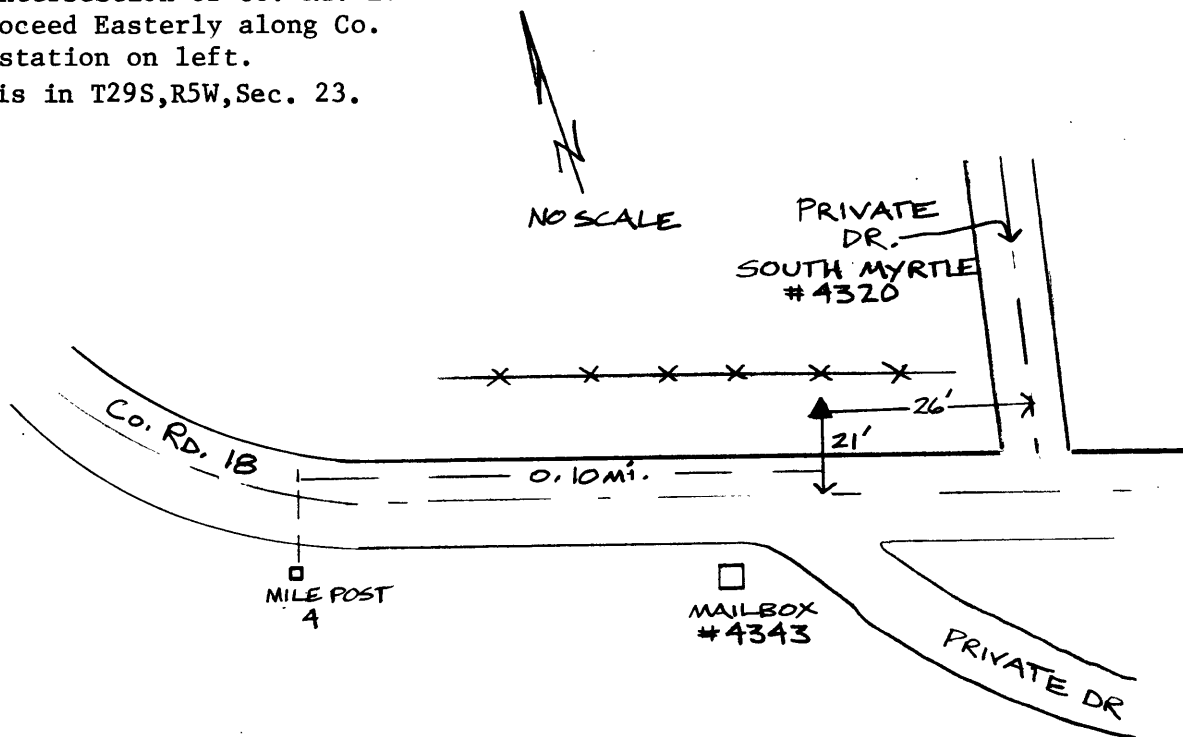

Note: For further information, contact the Douglas County Surveyor's Office, Room 205 Douglas County Justice Building, Roseburg, OR 97470. Phone 440-4278. Douglas County residents outside the Roseburg calling area, dial toll free 1-800-452-0991.