

OFFICE OF THE
DOUGLAS COUNTY SURVEYOR



M-079
M79

29S 5W 22

NAD 509600.05 4177843.23
83 43° 1'52" 123°16'52"

VERTICAL CONTROL NGVD 29

Elevation: 717.5 NGS Line # _____ USGS Line # _____ OSHD Line # _____

Precision: GPS Agency: DCSO Proj. # 2017-1 CS64/22 Date: 1991

HORIZONTAL CONTROL

South Zone O.C.S. 27: Y(Northing) 509,635.64 X(Easting) 1,256,884.77

South Zone O.C.S. 83: Y(Northing) _____ X(Easting) _____

Precision: 1/15,000 Agency: DCSO Proj. # 2017-1 CS 64/22 Date: 1991


Approx. NAD 83 Geographic Position: Latitude _____ Longitude _____

DESCRIPTION and TO REACH

Set: A standard DCSO disk stamped "M79 1991"
set in concrete curb.

To Reach: Mon is in the curb on the South side
of Craig St. 15 ft. east from end of
curb at the interseciton with Spruce
St. in Myrtle Creek.

SKETCH

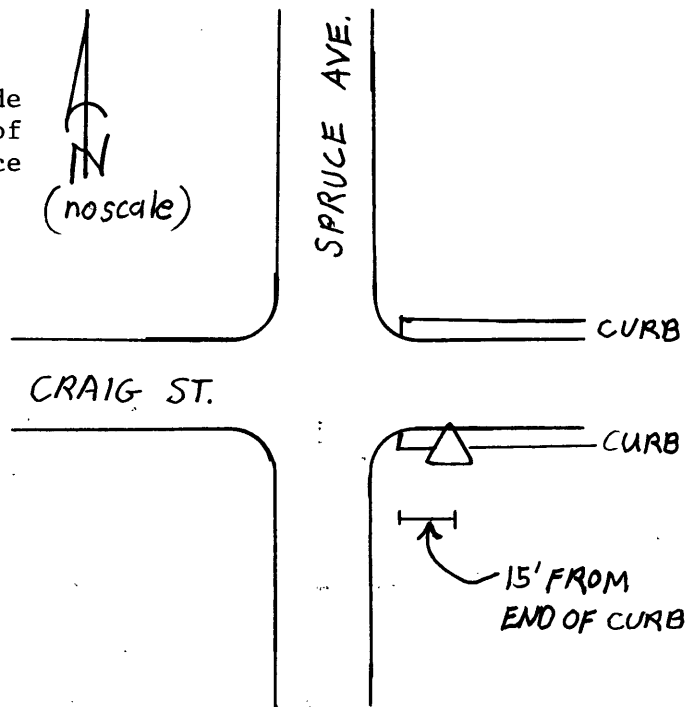

Reference Marks:

Note: For further information, contact the Douglas County Surveyor's Office, Room 205
Douglas County Justice Building, Roseburg, OR 97470. Phone 440-4278. Douglas
County residents outside the Roseburg calling area, dial toll free 1-800-452-0991.

Station: M79

T 29 S, R 5W , Sec 22

Date Set: 1991

Set By (Agency): City of M.C.

Date Recovered: 10/11/91

Recovered By: Ruppert LS 866

Date Recovered: _____

Recovered By: _____

Date Recovered: _____

Recovered By: _____

