

OFFICE OF THE  
DOUGLAS COUNTY SURVEYOR

Station: M86

T29W R5W Sec. 27

Date Set: 1991

Set By (Agency): CITY OF M.C.

DCSO Designation: M-086

Date Recovered: 11-18-91



Recovered By: RUPPERT LS #866

Date Recovered: \_\_\_\_\_

Recovered By: \_\_\_\_\_

Date Recovered: \_\_\_\_\_

Recovered By: \_\_\_\_\_

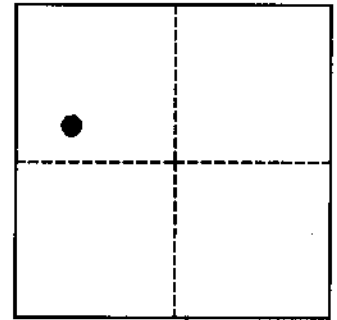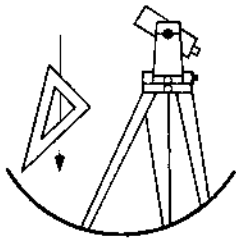

VERTICAL CONTROL

NGVD 29 Elevation: 605<sup>35</sup> FEET      NAVD 88 Elevation: \_\_\_\_\_ METERS

NGS Line # \_\_\_\_\_ USGS LINE # \_\_\_\_\_ OSHD Line # \_\_\_\_\_ FILE # \_\_\_\_\_

Precision: 3<sup>rd</sup> Agency: PRIVATE Proj: CS 63/1365 Date: 1993

HORIZONTAL CONTROL

O.C.S. 27 Y(Northing): 506,497.75      O.C.S. 83 Y(Northing): 506,462.16

(South Zone) X(Easting): 1,256,630.92      (South Zone) X(Easting): 4,177,589.37


Precision: 1/15,000 Agency: DCSO Proj: 2017-1 CS 64/22 Date: 1991

Approx. O.C.S. 27 Geographic Position: Latitude: 43°01'21" Longitude: 123°16'50"

Approx. O.C.S. 83 Geographic Position: Latitude: 43°01'21" Longitude: 123°16'54"

Set: A standard DCSO disk stamped "M86 1991" set in a mass of concrete flush with the ground.

To reach: From the intersection of North Main St. (Old Hwy 99S) and Riverside Dr. (Co. Rd. #18A) (Myrtle Creek) in T29S R5W Sec28 proceed easterly along Riverside Drive Approx. 0.35 miles to monument on right.

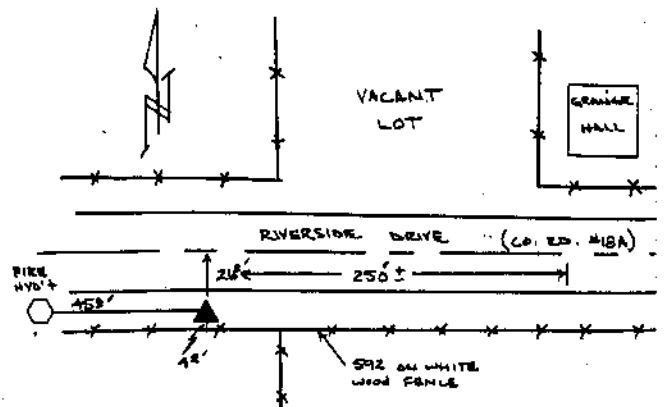

Note: For further information contact the Douglas County Surveyors Office, Room 205 Douglas County Justice Building, Roseburg, OR 97470. Phone 440-4272. Douglas County Residents outside Roseburg calling area, dial toll free 1-800-477-0991.