

OFFICE OF THE
DOUGLAS COUNTY SURVEYOR

Station: N 565 T 29 S, R 5 W , Sec 28

Set By (Agency): OSHD

Date Set: 1958

Recovered By PB,RS


Date Recovered 11/8/83

Recovered By _____


Date Recovered _____

Recovered By _____

Date Recovered _____

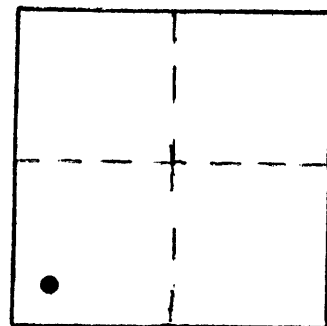

N-011
N 565

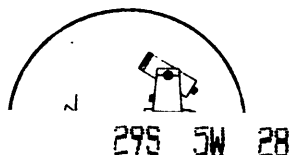

NAD 83 504067.90 4172366.14
43° 0'56" 123°18' 3"

VERTICAL CONTROL NGVD 29

Elevation: 640.54 NGS Line # _____ USGS Line # _____ OSHD Line # 369

Precision: 3rd Agency: OSHD Proj. # _____ Date: 1977

HORIZONTAL CONTROL OCS 27

South Zone State Plane Coordinates: Y(Northing) 504,103.49 X(Easting) 1,251,407.64

Precision: 1/25,000 Agency: DCSO Proj. # 2008 Date: 1978

Approximate Geographic Position: Latitude 43°00'56" Longitude 123°17'59"

DESCRIPTION and TO REACH


SKETCH

DESCRIPTION:

A disk stamped "N 565 1958" set flush
on the SW corner of bridge curbing.

TO REACH:

Go to the I-5 overpass of SPRR approx. 0.5
miles south of north entrance to Myrtle Creek
(exit #108) in T29S,R5W,Sec.28.

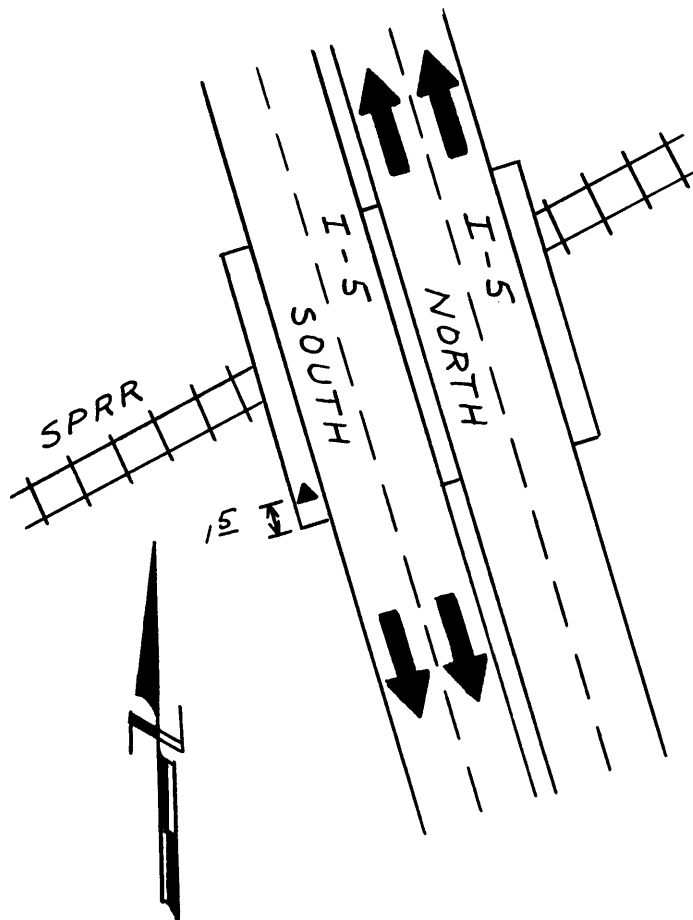

Reference Marks:

Note: For further information, contact the Douglas County Surveyor's Office, Room 205
Douglas County Justice Building, Roseburg, OR 97470. Phone 440-4278. Douglas
County residents outside the Roseburg calling area, dial toll free 1-800-452-0991.