



OFFICE OF THE
DOUGLAS COUNTY SURVEYOR

Station: PORTER T 29 S, R 6 W, Sec 8
Set By (Agency): DCSO
Date Set: 1972
Recovered By PB, RS
Date Recovered 11/15/83
Recovered By RWS, SJF
Date Recovered 11/85; DCSO 1/2001
Recovered By _____
Date Recovered _____

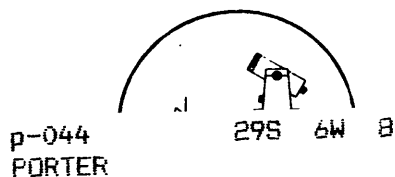

NAD 520813.64 4137950.26
83 43° 3' 29" 123° 25' 54"

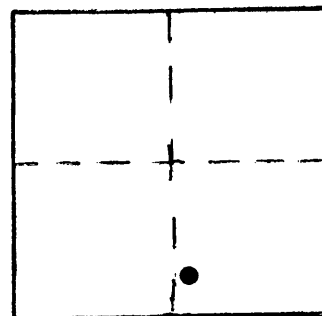

VERTICAL CONTROL NGVD 29

Elevation: 657.66 NGS Line # _____ USGS Line # _____ OSHD Line # _____
Precision: 3rd Agency: DCSO Proj. # 66/55 Date: 2001

HORIZONTAL CONTROL OCS 27

South Zone State Plane Coordinates: Y(Northing) 520,848.80 X(Easting) 1,216,992.05
Precision: 1/25,000 Agency: DCSO Proj. # 2004-15 CS56/23 Date: 1973
Approximate Geographic Position: Latitude 43°03'30" Longitude 123°25'50"

DESCRIPTION and TO REACH


SKETCH

DESCRIPTION:

A disk stamped "PORTER 1972" set in a concrete filled belltile 1.0 ft. above the ground.

TO REACH:

From the intersection of Rice Creek Rd.
(Co. Rd. #43) and Willis Creek Rd.
(Co. Rd. #88) in T29S, R6W, Sec. 4; proceed
southerly along Rice Creek Rd. 2.15 miles
to monument on the left.

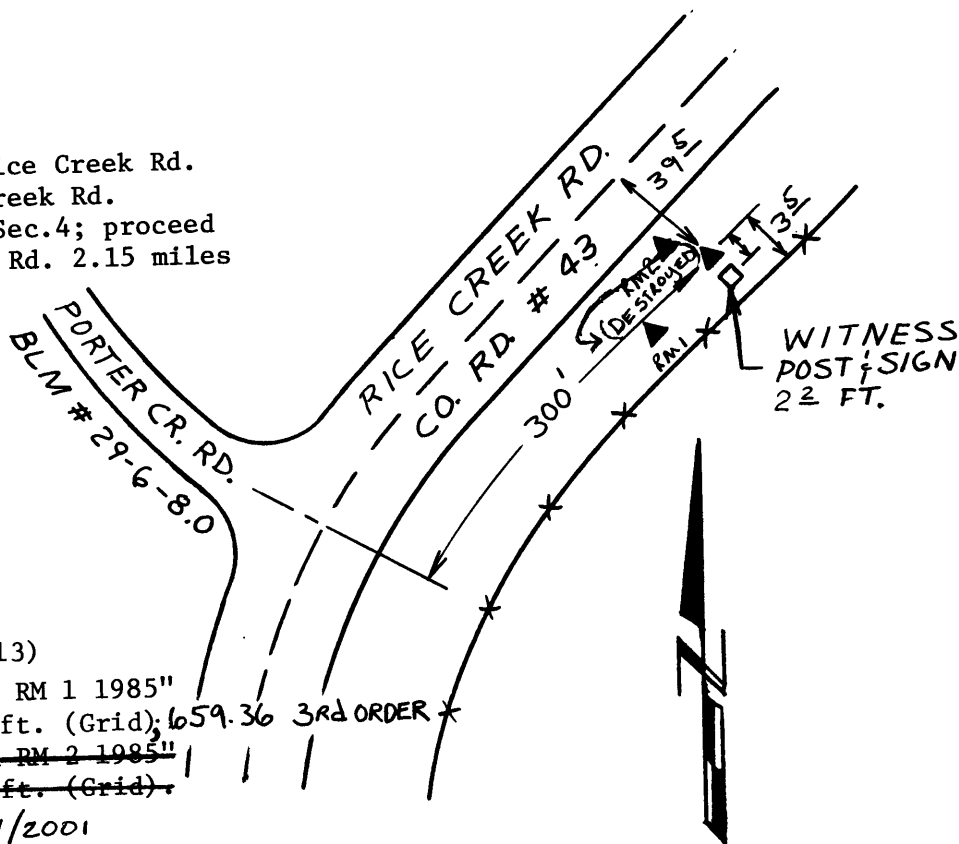

Reference Marks: (Proj. 2013)

A DCSO disk stamped "PORTER RM 1 1985"
bears S.46°22'47"W., 25.22 ft. (Grid); 659.36 3rd ORDER
~~A DCSO disk stamped "PORTER RM 2 1985"~~
~~bears N.38°17'29"W., 17.32 ft. (Grid).~~

→ DESTROYED PER DCSO 1/2001

Note: For further information, contact the Douglas County Surveyor's Office, Room 205
Douglas County Justice Building, Roseburg, OR 97470. Phone 440-4278. Douglas
County residents outside the Roseburg calling area, dial toll free 1-800-452-0991.