



OFFICE OF THE
DOUGLAS COUNTY SURVEYOR

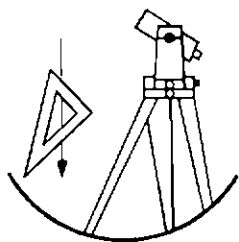

Station: E 747
Date Set: 1987
Set By (Agency): NGS
DCSO Designation: E-034
Date Recovered: AUG. 1993
Recovered By: RWS-SJF
Date Recovered: _____
Recovered By: _____
Date Recovered: _____
Recovered By: _____

T29S R6W Sec. 12

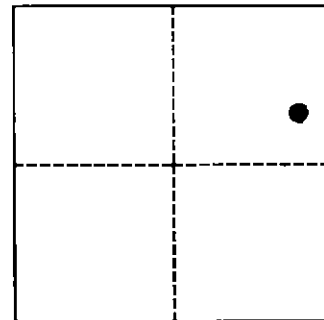

VERTICAL CONTROL


NGVD 29 Elevation: _____ FEET NAVD 88 Elevation: 177.553 METERS
NGS Line # 125042 USGS LINE # _____ OSHD Line # _____ FILE # _____
Precision: 1ST ORDER Agency: NGS Proj: _____ Date: 1988

HORIZONTAL CONTROL

O.C.S. 27 Y(Northing): _____ O.C.S. 83 Y(Northing): _____
(South Zone) X(Easting): _____ (South Zone) X(Easting): _____
Precision: _____ Agency: _____ Proj: _____ Date: _____
Approx. O.C.S. 27 Geographic Position: Latitude: 43°03'54" Longitude: 123°20'46"
Approx. O.C.S. 83 Geographic Position: Latitude: _____ Longitude: _____

Found: A 3 - 1/2 inch diameter NGS disk stamped "E 747 1987" set flush in small ledge of rock cut bank approx. 1 - 1/2 feet above ground level.

To reach: From the intersection of Clarks Branch Rd. (Co. Rd. #105) and Dole Rd. (Co. Rd. #14) in T29S R6W Sec1 proceed southerly along Dole Rd. approx. 1.0 miles to a point just past the I-5 under crossing and at the railroad grade crossing to the monument on left.

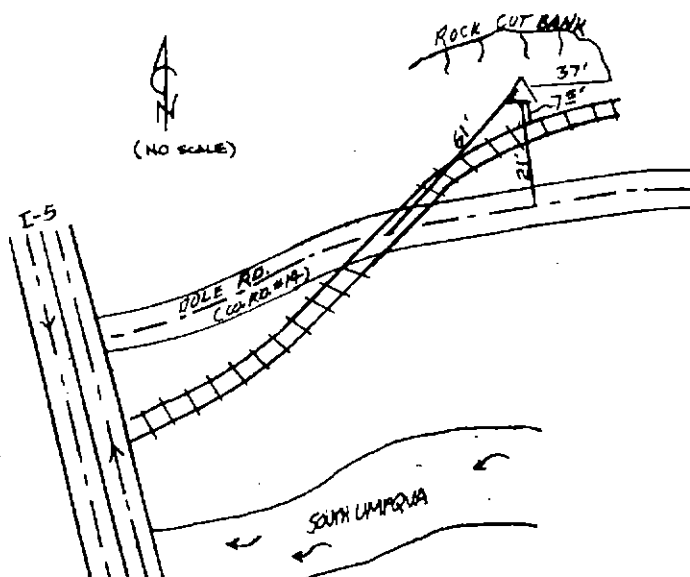

Note: For further information contact the Douglas County Surveyors Office, Room 205 Douglas County Justice Building, Roseburg, OR 97470. Phone 440-4272. Douglas County Residents outside Roseburg calling area, dial toll free 1-800-477-0991.