

Douglas County Geodetic Data Sheet


Station: RC-7

Designation: R-103

T 29 R 06 WS 19 D

Date Set: 1998 Set By (Agency): DCSO

Last Date Recovered: 12/00/2000

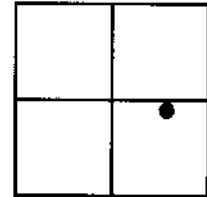

VERTICAL CONTROL

NGVD 29 Elevation: 803.64 Feet

Precision: 3RD ORDER Agency: DCSO

CS File: 66055

Date: 1998

NAVD 88 Elevation: Meters

Precision: Agency:

CS File:

Date:

HORIZONTAL CONTROL

OCS 27 Y(Northing): X(Easting): Lat 43° 02' 04.1" Long: 123° 26' 46.1"

Precision: GIS Agency: CS File: Date:

OCS 83 Y(Northing): X(Easting): Lat Long:

Precision: Agency: CS File: Date:

OCS 83/91 Y(Northing): X(Easting): Lat Long:

Precision: Agency: CS File: Date:

OCS 83/98 Y(Northing): X(Easting): Lat Long:


Precision: Agency: CS File: Date:

Description: Scaled Lat 43° 02' 04" Long: 123° 26' 46"

A DCSO BRASS CAP STAMPED; RC-7 1998; SET IN A 8 X 42 INCH CONCRETE FILLED BELL TILE; PROTRUDES 4 IN. ABOVE GROUND.

Comments:

FROM THE INTERSECTION OF WILLIS CREEK RD; CO. RD 43; AND RICE CREEK RD; CO. RD 43A; IN T29S R6W SEC.4 PROCEED SOUTHERLY ALONG RICE CREEK ROAD APPROX.4.0 MILES TO MONUMENT ON RIGHT.

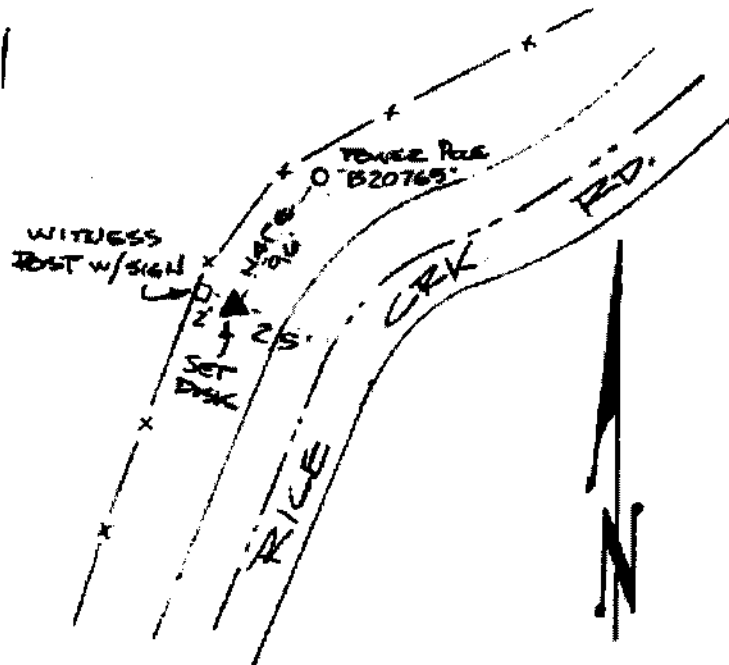

Notes:

Note: For further information contact the Douglas County Surveyors Office, Room 105A Douglas County Courthouse, Roseburg, OR 97470. Phone 440-4272 or Fax (541)957-8150. Douglas County Residents outside Roseburg calling area, dial toll free 1-800-224-1619.