



OFFICE OF THE
DOUGLAS COUNTY SURVEYOR

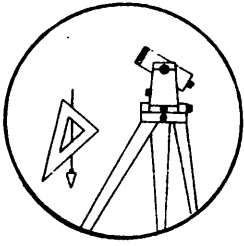

S-025

Station: S 76 T 29 S, R 8 W, Sec 30
 Set By (Agency): OSHD
 Date Set: 1931
 Recovered By RS, PB
 Date Recovered 11/17/83
 Recovered By _____
 Date Recovered _____
 Recovered By _____
 Date Recovered _____

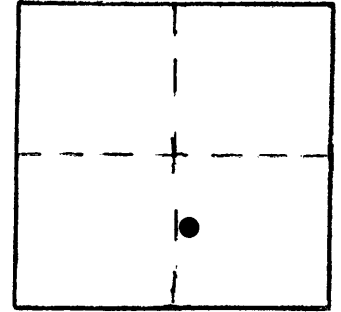

VERTICAL CONTROL **NGVD 29**

Elevation: 1,080.657 NGS Line # 27 USGS Line # _____ OSHD Line # _____
 Precision: 2nd Agency: USC&GS Proj. # _____ Date: 1957

HORIZONTAL CONTROL

South Zone State Plane Coordinates: Y(Northing) _____ X(Easting) _____
 Precision: _____ Agency: _____ Proj. # _____ Date: _____
 Approximate Geographic Position: Latitude _____ Longitude _____

DESCRIPTION and TO REACH


SKETCH

DESCRIPTION:

A disk stamped "S 76 1931" set flush on southerly end of easterly headwall of concrete box culvert.

TO REACH:

From the intersection of State Hwy. 42 and South Camas Rd. (Co. Rd. #131S) in T29S, R8W, Sec.20, proceed southwesterly along State Hwy. 42 1.00 miles to monument on left.

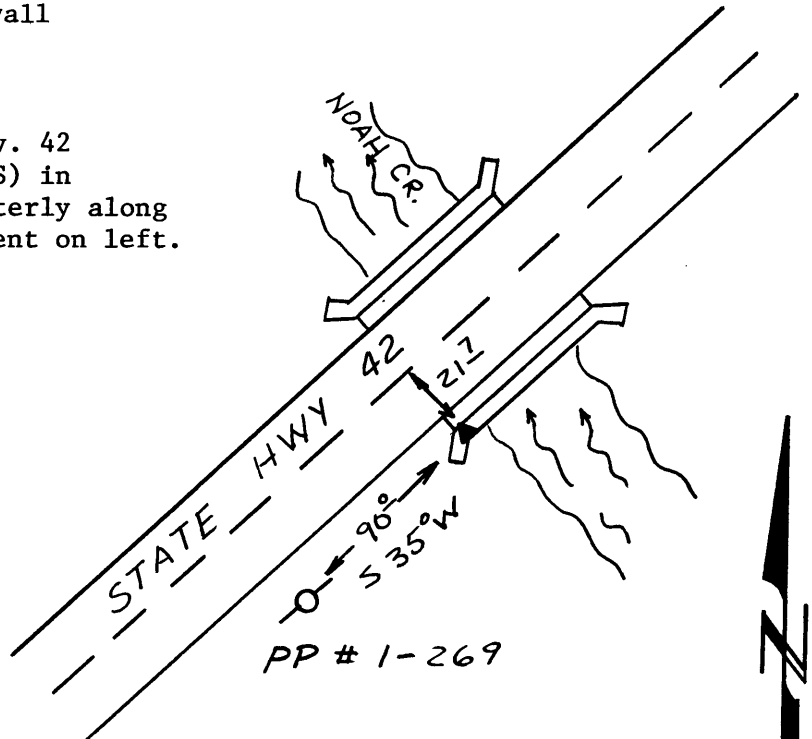

Reference Marks:

Note: For further information, contact the Douglas County Surveyor's Office, Room 205 Douglas County Justice Building, Roseburg, OR 97470. Phone 440-4278. Douglas County residents outside the Roseburg calling area, dial toll free 1-800-452-0991.