



OFFICE OF THE
DOUGLAS COUNTY SURVEYOR

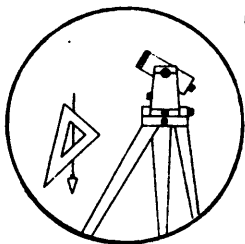

L-012

Station: L 499
Set By (Agency): USC&GS
Date Set: 1949
Recovered By RS-JP
Date Recovered 2-9-82
Recovered By _____
Date Recovered _____
Recovered By _____
Date Recovered _____

T 30 S, R 5W , Sec 19

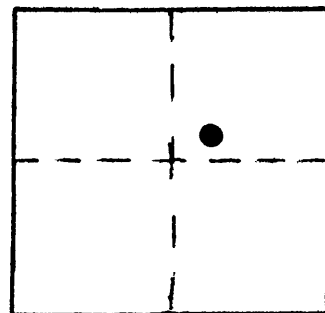

VERTICAL CONTROL NGVD 29

Elevation: 706.504 NGS Line # 130 USGS Line # _____ OSHD Line # _____
Precision: 2nd Agency: USC&GS Proj. # _____ Date: 1957

HORIZONTAL CONTROL


South Zone State Plane Coordinates: Y(Northing) _____ X(Easting) _____
Precision: _____ Agency: _____ Proj. # _____ Date: _____
Approximate Geographic Position: Latitude _____ Longitude _____

DESCRIPTION and TO REACH

SKETCH

Found: A standard USC&GS disk stamped "L 499 1949" set in a concrete post flush with the ground.

To reach: Monument is located near exit 102 overpass of I-5 and Co. Rd.*35 (Gazley Rd.) in T30S R5W sec. 19.

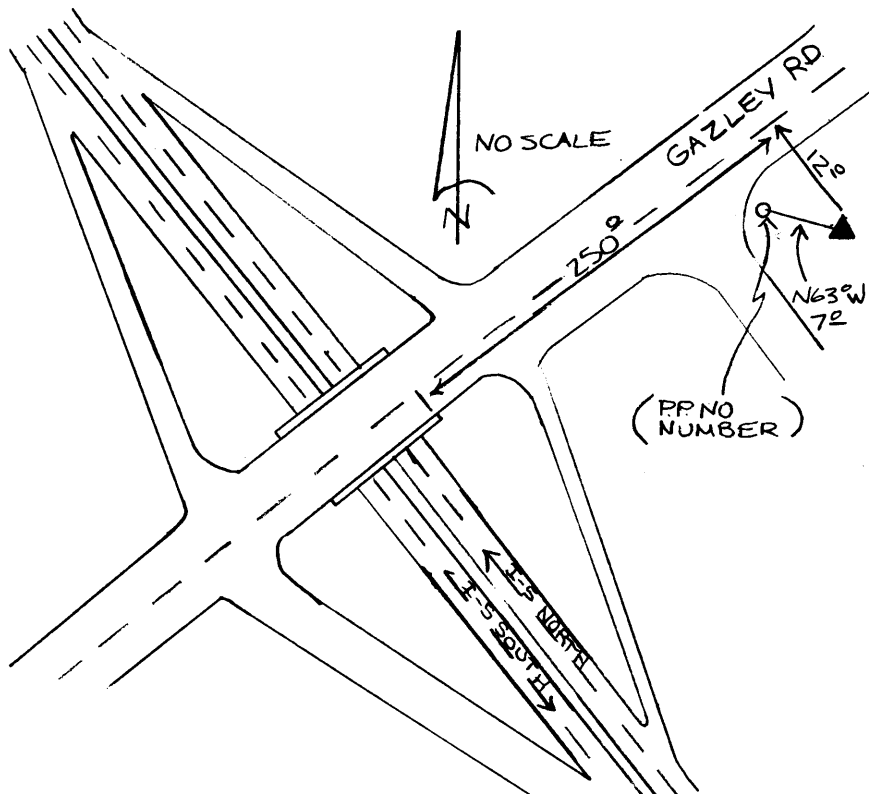

Reference Marks:

Note: For further information, contact the Douglas County Surveyor's Office, Room 205 Douglas County Justice Building, Roseburg, OR 97470. Phone 440-4278. Douglas County residents outside the Roseburg calling area, dial toll free 1-800-452-0991.