



OFFICE OF THE
DOUGLAS COUNTY SURVEYOR

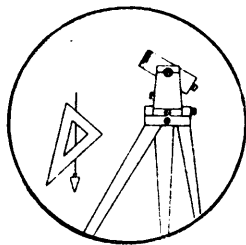

X-018

Station: X 552 T 30 S, R 6 W , Sec 23
Set By (Agency): USC&GS
Date Set: 1954
Recovered By RWS, SJF
Date Recovered Nov. 7, 1988
Recovered By _____
Date Recovered _____
Recovered By _____
Date Recovered _____

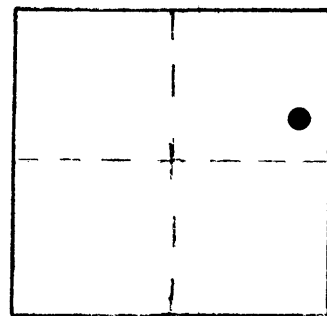

VERTICAL CONTROL NGVD 29

Elevation: 710.087 ft. NGS Line # 6 USGS Line # _____ OSHD Line # _____
Precision: 1st. order Agency: USC&GS Proj. # 2013 Date: 1957

HORIZONTAL CONTROL

South Zone State Plane Coordinates: Y(Northing) _____ X(Easting) _____
Precision: _____ Agency: _____ Proj. # _____ Date: _____
Approximate Geographic Position: Latitude _____ Longitude _____


DESCRIPTION and TO REACH

SKETCH

A 3 1/2 inch diameter USC&GS disk stamped "X 552 1954" set flush near center of top of a concrete foundation pad which formerly supported a railroad semaphore signal. Pad protrudes approximately 6 inches above ground.

From the intersection of Fifth Avenue and Main Street in Riddle, Oregon, T30S R6W, Section 24 proceed northwesterly along Main Street approximately 200 feet to monument on left, approximately 110 feet southwesterly from roadway centerline.

Reference Marks:

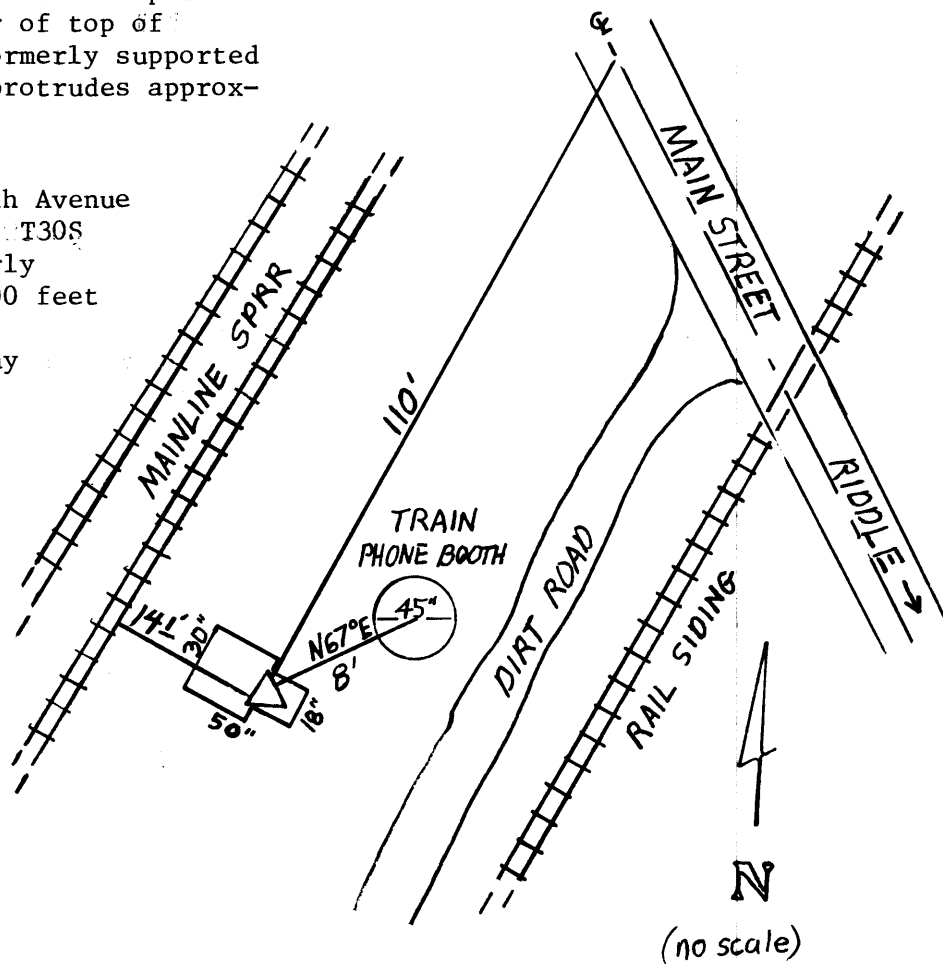

Note: For further information, contact the Douglas County Surveyor's Office, Room 205 Douglas County Justice Building, Roseburg, OR 97470. Phone 440-4278. Douglas County residents outside the Roseburg calling area, dial toll free 1-800-452-0991.