



OFFICE OF THE
DOUGLAS COUNTY SURVEYOR

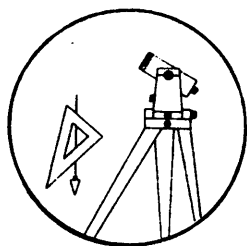

U-079

Station: U 76
Set By (Agency): USC&GS
Date Set: 1931
Recovered By PB,RS
Date Recovered 11/16/83
Recovered By _____
Date Recovered _____
Recovered By _____
Date Recovered _____

T 30 S, R 9 W , Sec 2

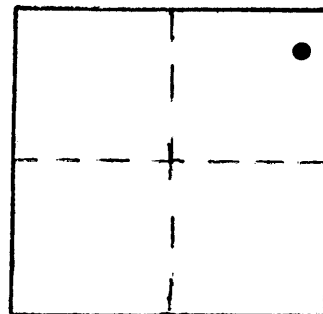

VERTICAL CONTROL **NGVD 29**

Elevation: 1,037.498 NGS Line # 27 USGS Line # _____ OSHD Line # _____
Precision: 2nd Agency: USC&GS Proj. # _____ Date: 1957

HORIZONTAL CONTROL

South Zone State Plane Coordinates: Y(Northing) _____ X(Easting) _____

Precision: _____ Agency: _____ Proj. # _____ Date: _____

Approximate Geographic Position: Latitude _____ Longitude _____

DESCRIPTION and TO REACH


SKETCH

DESCRIPTION:

A disk stamped "U 76 1931" set flush
in a 10 in. square concrete post 6 in.
above ground.

TO REACH:

From the intersection of State
Hwy. 42 and Signal Tree L.O.
Rd. (BLM #29-9-36.0) in T30S,
R9W,Sec.1, proceed southwesterly
along State Hwy. 42 0.35 miles
to monument on right.

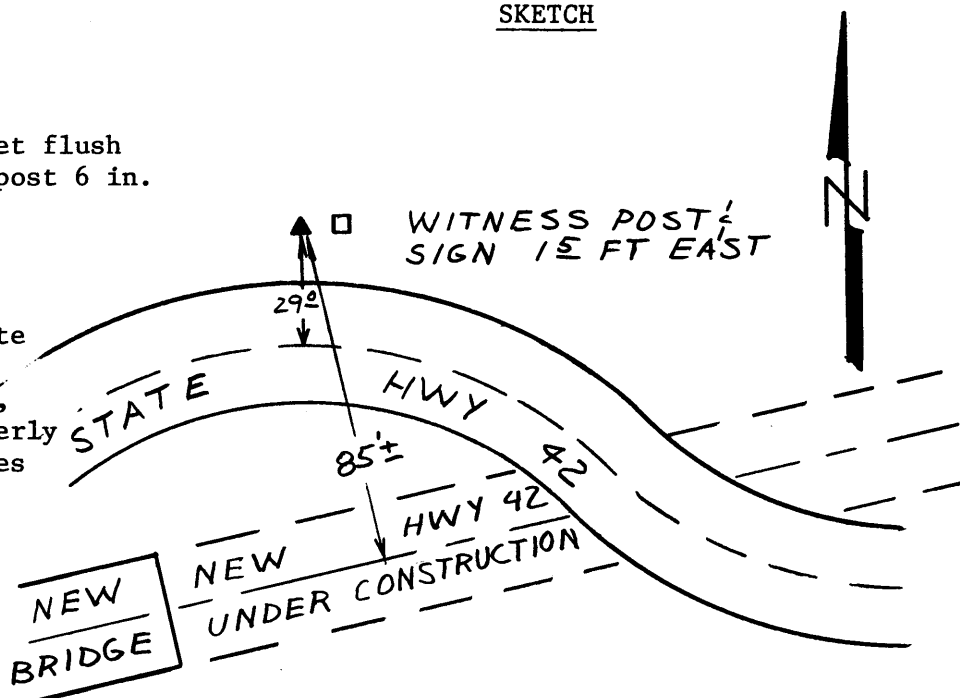

Reference Marks:

Note: For further information, contact the Douglas County Surveyor's Office, Room 205
Douglas County Justice Building, Roseburg, OR 97470. Phone 440-4278. Douglas
County residents outside the Roseburg calling area, dial toll free 1-800-452-0991.