



OFFICE OF THE
DOUGLAS COUNTY SURVEYOR

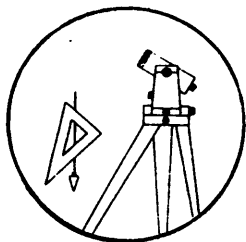

Y-021

Station: Y501 T 31 S, R 1 E, Sec 10
Set By (Agency): USC&GS
Date Set: 1949
Recovered By RWS, SJF
Date Recovered 8/17/87
Recovered By _____
Date Recovered _____
Recovered By _____
Date Recovered _____

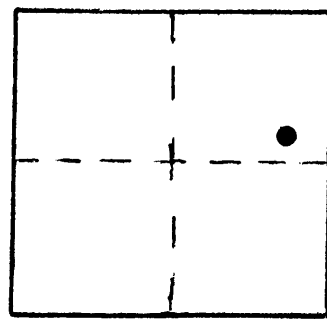

VERTICAL CONTROL NGVD 29

Elevation: 5204.209 NGS Line # 130 USGS Line # _____ OSHD Line # _____
Precision: 2nd Agency: USC&GS Proj. # _____ Date: 1957

HORIZONTAL CONTROL

South Zone State Plane Coordinates: Y(Northing) _____ X(Easting) _____
Precision: _____ Agency: _____ Proj. # _____ Date: _____
Approximate Geographic Position: Latitude _____ Longitude _____

DESCRIPTION and TO REACH

SKETCH


A USC&GS disk stamped "Y501 1949" set in a
4 ft. X 2 1/2 ft. boulder protruding 1ft. above
ground.

TO REACH:

From the four -way intersection of USFS roads
#2925, #600, #700 and #800 in T31S, R1E, Sec. 44
proceed southeasterly along USFS Rd. #800
approx. 2.1 miles to small clearing and
monument on right.

From the intersection of USFS Rd. #800
and #810 (road to Butler Butte) in T31S,
R1E, Sec. 10, proceed westerly along USFS
Rd. #800 approx. 0.2 miles to monument on
left.

Reference Marks:

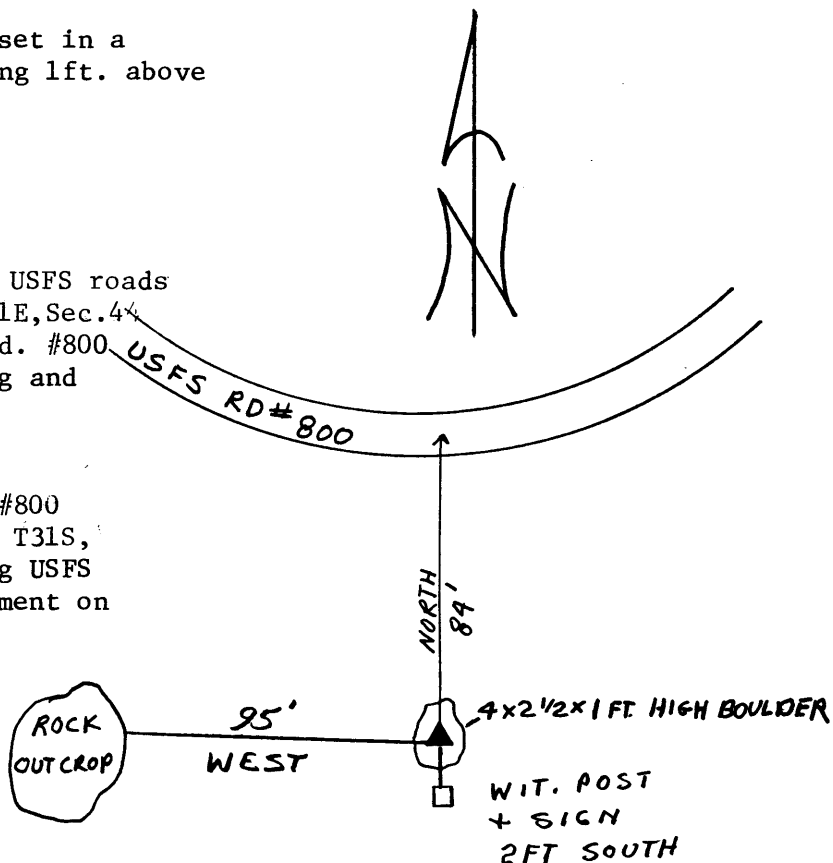

Note: For further information, contact the Douglas County Surveyor's Office, Room 205
Douglas County Justice Building, Roseburg, OR 97470. Phone 440-4278. Douglas
County residents outside the Roseburg calling area, dial toll free 1-800-452-0991.