
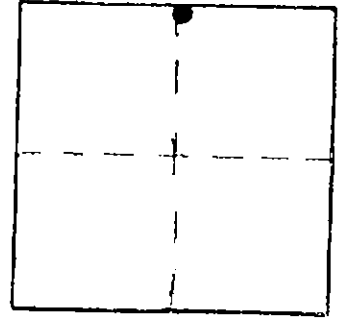


OFFICE OF THE
DOUGLAS COUNTY SURVEYOR

Station: L 29 T 31 S, R 1 E, Sec 16
Set By (Agency): USGS
Date Set: 1943
Recovered By RWS,SJF
Date Recovered 8/17/87
Recovered By _____
Date Recovered _____
Recovered By _____
Date Recovered _____

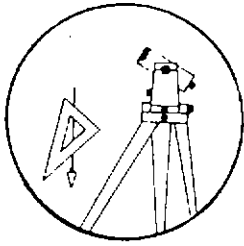

VERTICAL CONTROL

Elevation: 3982.269 NGS Line # 130 USGS Line # _____ OSHD Line # _____
Precision: 2nd Agency: USC&GS Proj. # _____ Date: 1957

HORIZONTAL CONTROL

South Zone State Plane Coordinates: Y(Northing) _____ X(Easting) _____
Precision: _____ Agency: _____ Proj. # _____ Date: _____
Approximate Geographic Position: Latitude _____ Longitude _____


DESCRIPTION and TO REACH

SKETCH

A USGS disk stamped "L 29 1943" set in a 11"x14" concrete post protruding 2 in. above ground.

TO REACH:

Go to the intersection of USFS Rd. #2925, #6620 and #805 in T31S,R1E,Sec.16, proceed northeasterly on foot along USFS Rd. #805 (no longer suitable for vehicles) approx. 0.25 miles to monument on right(south of road).

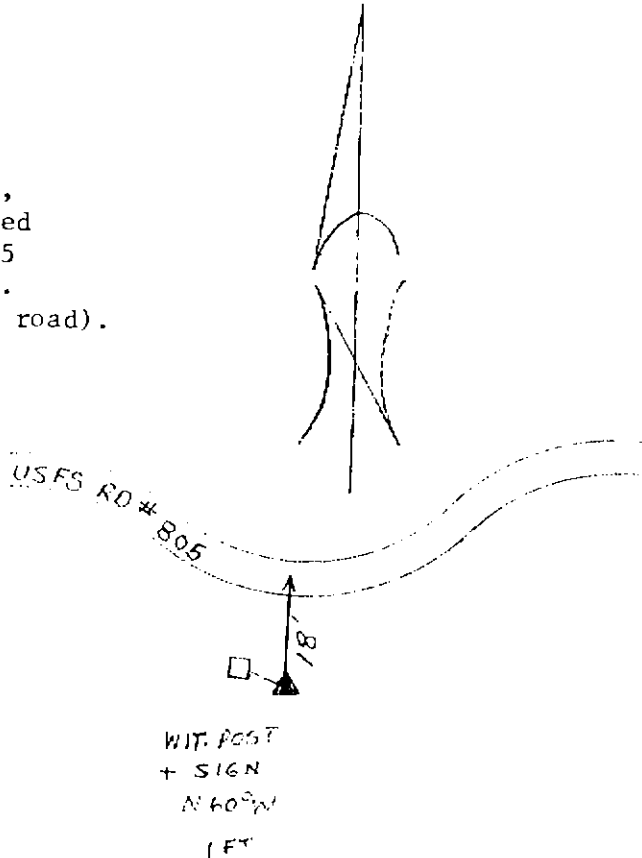

Reference Marks:

Note: For further information, contact the Douglas County Surveyor's Office, Room 205 Douglas County Justice Building, Roseburg, OR 97470. Phone 440-4278. Douglas County residents outside the Roseburg calling area, dial toll free 1-800-452-0991.