



OFFICE OF THE
DOUGLAS COUNTY SURVEYOR

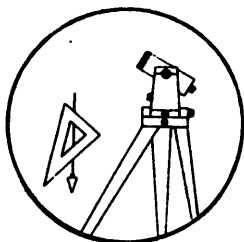

T-013

Station: T500 T 31 S, R 2 W, Sec 11
Set By (Agency): USC&GS
Date Set: 1949
Recovered By RS,SF
Date Recovered 1/18/84
Recovered By _____
Date Recovered _____
Recovered By _____
Date Recovered _____

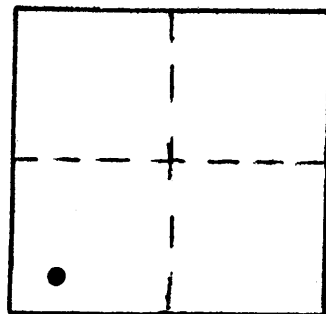

VERTICAL CONTROL NGVD 29

Elevation: 1298.888 NGS Line # 130 USGS Line # _____ OSHD Line # _____
Precision: 2nd Agency: USC&GS Proj. # _____ Date: 1957

HORIZONTAL CONTROL

South Zone State Plane Coordinates: Y(Northing) _____ X(Easting) _____
Precision: _____ Agency: _____ Proj. # _____ Date: _____
Approximate Geographic Position: Latitude _____ Longitude _____

DESCRIPTION and TO REACH

SKETCH

DESCRIPTION:

A USC&GS disk stamped "T500 1949" set
flush in center of north bridge curb.

TO REACH:

From the intersection of State Hwy 227
and Tiller-South Umpqua Rd. (Co. Rd. #46)
in T30S,R2W,Sec.33, proceed southeasterly along
State Hwy. 227, 3.4 miles to monument on left.


From the intersection of State Hwy. 227
and Devils Knob Rd. (U.S.F.S. Rd. #301)
in T31S,R2W,Sec.11, proceed westerly along
State Hwy. 227, 0.2 miles to monument on right.

no good elev. on
this disk

→ USC&GS DISK
STAMPED
"GAGING STATION"
REFERENCE
SET IN A 2'x1 1/2'
CONCRETE BLOCK

Reference Marks:

← GALVANIZED STEEL
GAGING TOWER

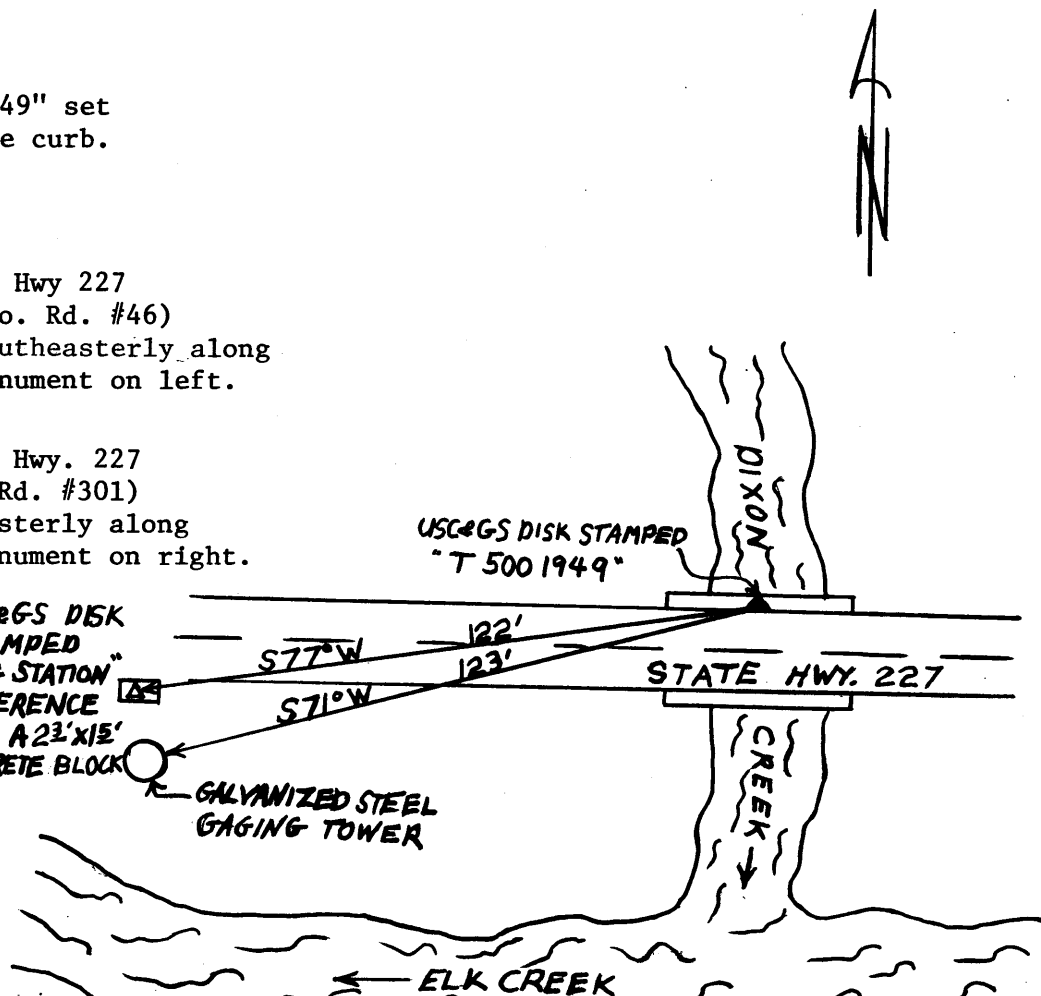

Note: For further information, contact the Douglas County Surveyor's Office, Room 205
Douglas County Justice Building, Roseburg, OR 97470. Phone 440-4278. Douglas
County residents outside the Roseburg calling area, dial toll free 1-800-452-0991.