
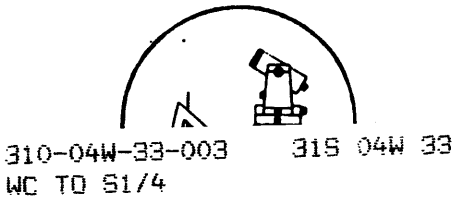


OFFICE OF THE
DOUGLAS COUNTY SURVEYOR

Station: WC TO S 1/4 T 31 S, R 4 W, Sec 33
 Set By (Agency): DCSO 340100
 Date Set: 1966
 Recovered By RS, JP
 Date Recovered 9/12/83
 Recovered By _____
 Date Recovered _____
 Recovered By _____
 Date Recovered _____

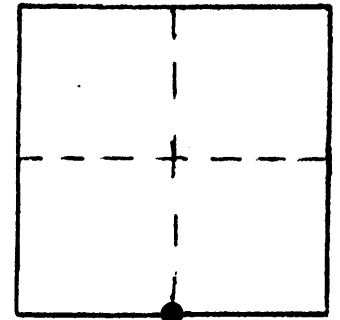

310-04W-33-003 31S 04W 33
 WC TO S1/4
 NAD 434298.21 4202547.93
 83 42°49'36" 123°10'47"

VERTICAL CONTROL

Elevation: 1711.633 NGS Line # _____ USGS Line # _____ OSHD Line # _____
 Precision: 2nd Agency: DCSO Proj. # 2006 Date: 1973

HORIZONTAL CONTROL

South Zone State Plane Coordinates: Y(Northing) 434,334.56 X(Easting) 1,281,589.06
 Precision: 1/25,000 Agency: DCSO Proj. # 2006 Date: 1973
 Approximate Geographic Position: Latitude 42°49'37" Longitude 123°10'43"


DESCRIPTION and TO REACH

DESCRIPTION: 25' EAST TO
 A DCSO disk stamped 1/4 S 33 R set on
 S 4 4
 T 32 S W
 1966
 a 1 1/2 in. diam. I.P. 12 in. above ground.

TO REACH:

From the intersection of BLM Rd. #32-4-4
 (White Horse Creek) and Co. Rd. #36
 (Upper cow creek Rd.) in T32S,R4W,Sec.4,
 proceed northerly along Co. Rd. #36 0.65 miles
 to monument on right.

SKETCH

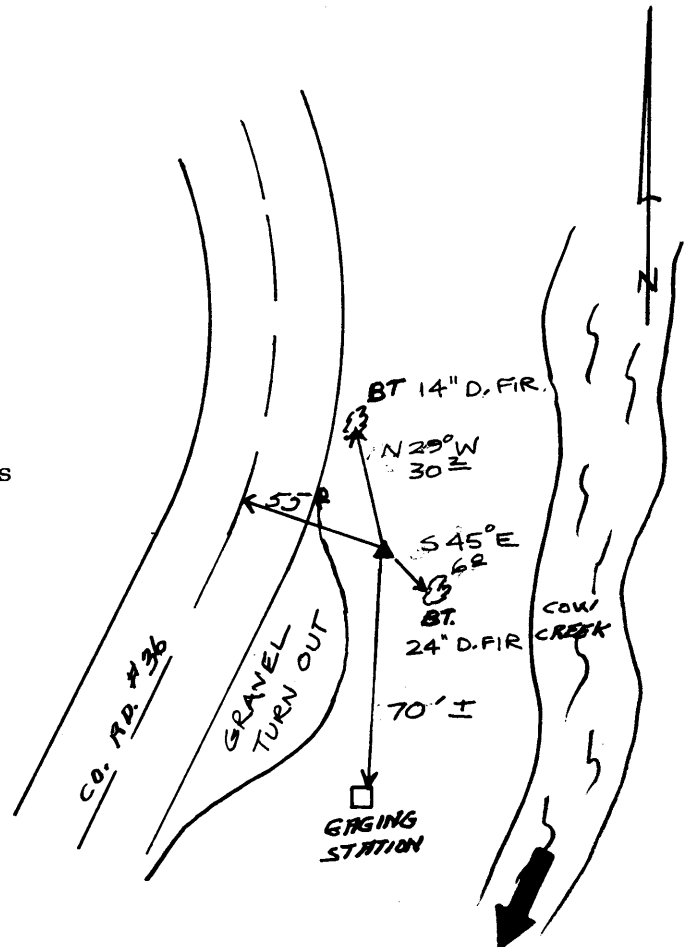

Reference Marks:

Note: For further information, contact the Douglas County Surveyor's Office, Room 205 Douglas County Justice Building, Roseburg, OR 97470. Phone 440-4278. Douglas County residents outside the Roseburg calling area, dial toll free 1-800-452-0991.