



OFFICE OF THE
DOUGLAS COUNTY SURVEYOR

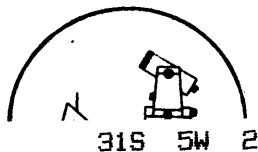

q-018
Q 615

NAD 462895.99 4184073.55
83 42°54'13" 123°15' 7"

Station: Q 615 T 31 S, R 5 W , Sec 2
Set By (Agency): OSHD
Date Set: 1966
Recovered By RWS,SJF
Date Recovered 1/30/85
Recovered By _____
Date Recovered _____
Recovered By _____
Date Recovered _____

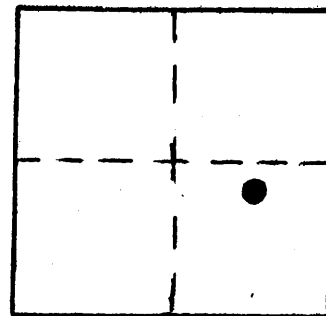

VERTICAL CONTROL **NGVD 29**

Elevation: 894.37 NGS Line # _____ USGS Line # _____ OSHD Line # 369
Precision: 3rd Agency: OSHD Proj. # _____ Date: 1980

HORIZONTAL CONTROL **OCS 27**

South Zone State Plane Coordinates: Y(Northing) 462,931.93 X(Easting) 1,263,114.89
Precision: 1/25,000 Agency: DCSO Proj. # 2013 Date: 1985
Approximate Geographic Position: Latitude 42°54'13" Longitude 123°15'03"

DESCRIPTION and TO REACH


SKETCH

DESCRIPTION:

An OSHD disk stamped "Q 615 1968" set
flush in concrete headwall of arch culvert.

TO REACH:

From the Richie Rd. overcrossing of I-5
(exit 95) in T31S,R5W,Sec.2, proceed
northerly along I-5 approx. 0.4 miles
to monument on right.

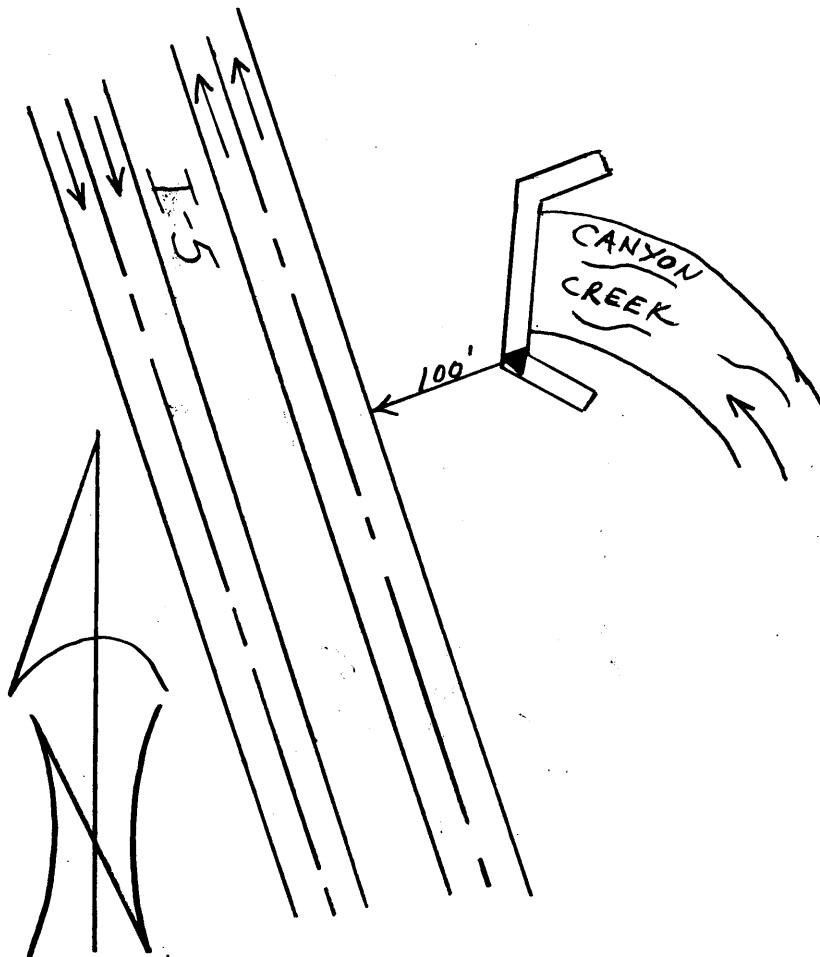

Reference Marks:

Note: For further information, contact the Douglas County Surveyor's Office, Room 205
Douglas County Justice Building, Roseburg, OR 97470. Phone 440-4278. Douglas
County residents outside the Roseburg calling area, dial toll free 1-800-452-0991.