

OFFICE OF THE
DOUGLAS COUNTY SURVEYOR

Station: PTS-10 T 32 S, R 5 W, Sec 11

Set By (Agency): DCSO

Date Set: 1973

Recovered By LEM


Date Recovered 7/81

Recovered By _____

Date Recovered _____

Recovered By _____

Date Recovered _____

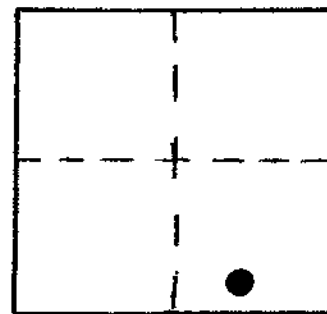

p-043 32S 5W 11
PTS-10

NAD 424881.10 4182643.92
BS 42°47'57" 123°15'10"

VERTICAL CONTROL

Elevation: 1667.197 NGS Line # _____ USGS Line # _____ OSHD Line # _____

Precision: 2nd Agency: DCSO Proj. # 2006 Date: 1973

HORIZONTAL CONTROL

South Zone State Plane Coordinates: Y(Northing) 424,917.34 X(Easting) 1,261,685.22

Precision: 1/25,000 Agency: DCSO Proj. # 2006 Date: 1973


Approximate Geographic Position: Latitude 42 47'58" Longitude 123 15'06"

DESCRIPTION and TO REACH

SKETCH

Station is a DCSO disk stamped "PTS-10 1973".

To Reach: From the intersection of the I-5 southbound off ramp to Azalea and Co. Rd. 36 overcrossing I-5, proceed Easterly along Co. Rd. 36 700 ft.. Station is in the SE corner of the concrete sign base for the sign pointing to AZALEA and COW CREEK RD., and is 270 ft. Easterly from the east end of the railing over I-5.

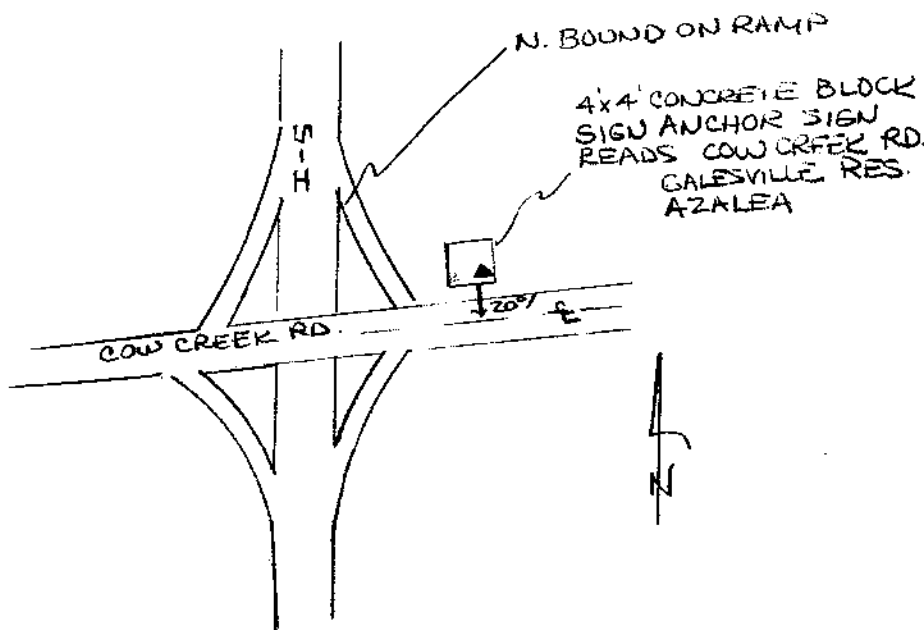

Reference Marks:

Note: For further information, contact the Douglas County Surveyor's Office, Room 205 Douglas County Justice Building, Roseburg, OR 97470. Phone 440-4278. Douglas County residents outside the Roseburg calling area, dial toll free 1-800-452-0991.