



OFFICE OF THE
DOUGLAS COUNTY SURVEYOR

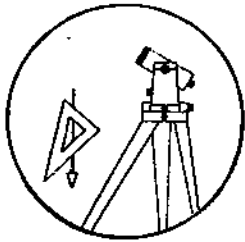

L 009

Station: L 353 T 32 S, R 6W, Sec 34
Set By (Agency): USC & GS
Date Set: 1942
Recovered By LEM - RWS
Date Recovered 2-82
Recovered By _____
Date Recovered _____
Recovered By _____
Date Recovered _____

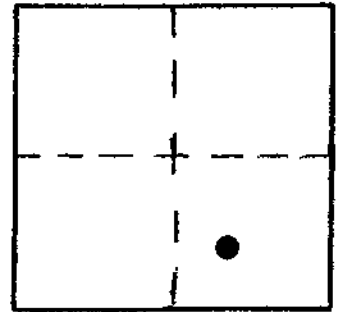

VERTICAL CONTROL

Elevation: 1451.008 NGS Line # _____ USGS Line # 6 OSHD Line # _____
Precision: 1st Agency: USC & GS Proj. # _____ Date: 1957

HORIZONTAL CONTROL


South Zone State Plane Coordinates: Y(Northing) _____ X(Easting) _____
Precision: _____ Agency: _____ Proj. # _____ Date: _____
Approximate Geographic Position: Latitude _____ Longitude _____

DESCRIPTION and TO REACH

SKETCH

Found: A standard USC & GS disk set in concrete post, flush with the ground stamped "L 353 1942"
A 4" x 4" white witness post is 1' NNE of monument.
Monument is 4' above pavement.

To reach: From the intersection of Co. Rd. #28 (Windy Creek Rd.) and Co. Rd. #12 (Fortune Branch) in sec 33 of T32S R6W, proceed easterly along Co. Rd. #12 1 mile to the monument on the left.

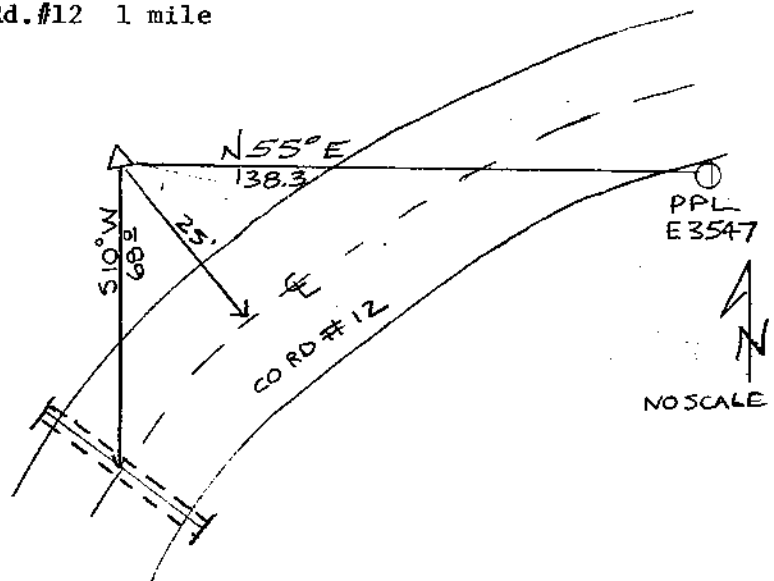

Reference Marks:

Note: For further information, contact the Douglas County Surveyor's Office, Room 205 Douglas County Justice Building, Roseburg, OR 97470. Phone 440-4278. Douglas County residents outside the Roseburg calling area, dial toll free 1-800-452-0991.