


OFFICE OF THE
DOUGLAS COUNTY SURVEYOR

Station: T 551 T 33 S, R 6 W , Sec 5
Set By (Agency): USC&GS
Date Set: 1954
Recovered By RS, PB
Date Recovered 11/3/83
Recovered By _____
Date Recovered _____
Recovered By _____
Date Recovered _____

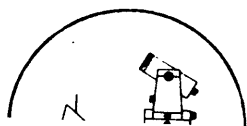

t-015
T 551

33S 6W 5

NAD 83 404558.76 4134538.74
 42°44'20" 123°25'45"

T-015

VERTICAL CONTROL NGVD 29

Elevation: 1415.164 NGS Line # _____ USGS Line # _____ OSHD Line # _____
Precision: 2nd Agency: DCSO Proj. # 2006 Date: 1973

HORIZONTAL CONTROL OCS 27

South Zone State Plane Coordinates: Y(Northing) 404,594.74 X(Easting) 1,213,580.18
Precision: 1/25,000 Agency: DCSO Proj. # 2006 Date: 1973
Approximate Geographic Position: Latitude 42°44'21" Longitude 123°25'41"

DESCRIPTION and TO REACH


SKETCH

DESCRIPTION:

A disk stamped "T551 1954" set
flush on a round concrete foundation.

TO REACH:

From the intersection of 3rd. St. and
Pacific Ave. in Glendale, proceed northerly
along 3rd. St. 0.1 miles to Gilbert Ave.
proceed westerly along Gilbert Ave. 0.15
miles; monument is approx. 200 ft. south
of road.

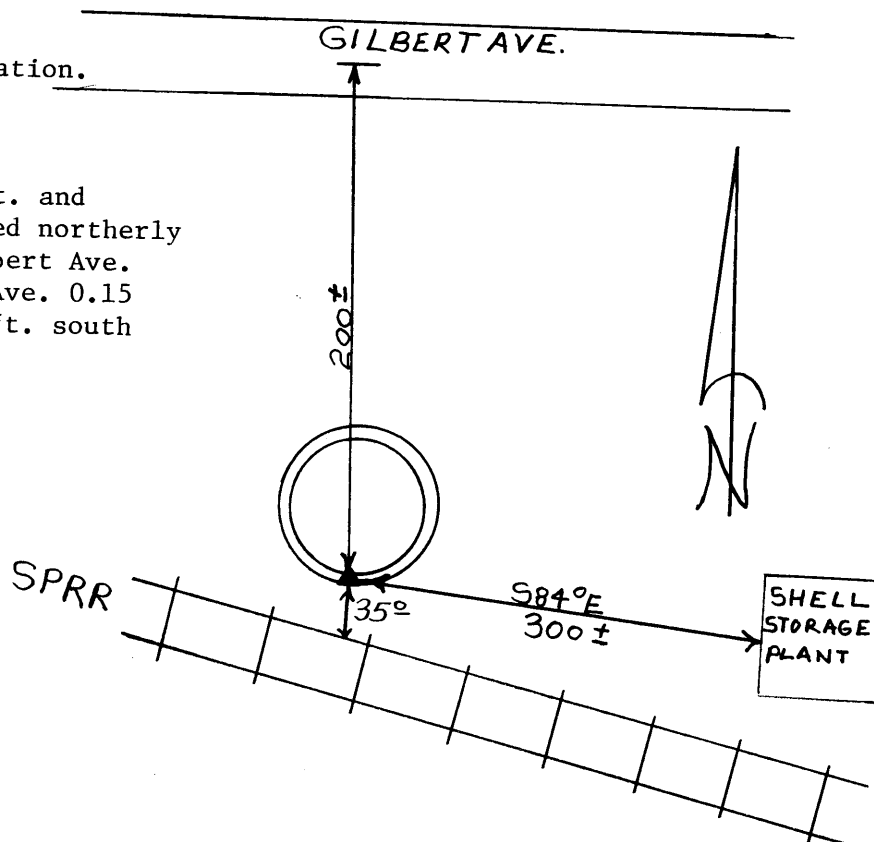

Reference Marks:

Note: For further information, contact the Douglas County Surveyor's Office, Room 205
Douglas County Justice Building, Roseburg, OR 97470. Phone 440-4278. Douglas
County residents outside the Roseburg calling area, dial toll free 1-800-452-0991.