


OFFICE OF THE
DOUGLAS COUNTY SURVEYOR

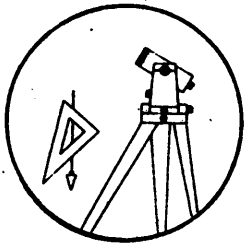

#-004

Station: 65 BB

T 22 S R 8W S 7


Date set: 1919

Set By (Agency): USGS

Date Recovered: 2-24-82

Recovered By: GP - RS

- | | |
|---|------------------------------------|
| <input checked="" type="checkbox"/> Found | <input type="checkbox"/> New |
| <input type="checkbox"/> Reset | <input type="checkbox"/> Not Found |
| <input type="checkbox"/> Referenced | <input type="checkbox"/> Destroyed |

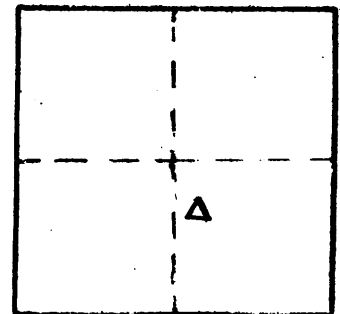

VERTICAL CONTROL NGVD 29

Elevation: 6567 NGS Line # _____ USGS Line # 207 OSHD Line # _____

Precision: 3rd Agency: USGS Proj. # _____ Date: 1948

HORIZONTAL CONTROL

South Zone State Plane Coordinates: Y(Northing) _____ X(Easting) _____

Precision: _____ Agency: _____ Proj. # _____ Date: _____

Approximate Geographic Position: Latitude 43°40'12.7" Longitude 123°41'38.2"

DESCRIPTION and TO REACH

FD. STANDARD U.S.G.S. BM BRASS CAP SET ON NORTH
SIDE OF LARGE BOULDER STAMPED "65 BB 1919".

TO REACH: SEE NGS INFO.

FROM THE INTERSECTION OF HWY. 38 & PARADISE CR ROAD #22-8-9.0
(IN SEC. 9 T22S R8W) PROCEED WESTERLY ALONG HWY. 38

3 MILES TO MONUMENT ON RIGHT

Reference Marks:

