

OFFICE OF THE  
DOUGLAS COUNTY SURVEYOR

Station: 50-9

T 27 S, R 5W, Sec 19

Set By (Agency): CITY (RSBG.)

Date Set: ?

Recovered By KR, TP


Date Recovered 5/82

Recovered By SJF, JP

Date Recovered 7/01

Recovered By \_\_\_\_\_

Date Recovered \_\_\_\_\_

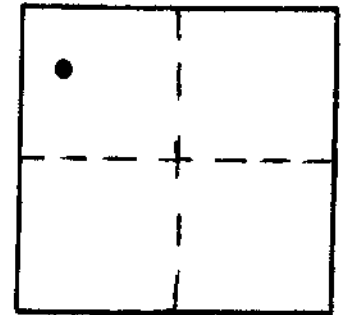

#-022  
50-9                      27S 5W 19

NAD            575994.92            4162874.55  
83            43°12'42"            123°20'43"

VERTICAL CONTROL **NGVD 29**

Elevation: 457.91            NGS Line # \_\_\_\_\_ USGS Line # \_\_\_\_\_ OSHD Line # \_\_\_\_\_

Precision: 3rd            Agency: DCSO            Proj. # \_\_\_\_\_            Date: 7/2001

HORIZONTAL CONTROL **NAD 27**

South Zone State Plane Coordinates: Y(Northing) 576,030.12            X(Easting) 1,241,936.23

Precision: 1/20,000            Agency: DCSO            Proj. # 2005-2            Date: 1983

Approximate Geographic Position: Latitude 43°12'43"            Longitude 123°20'39"

DESCRIPTION and TO REACH


SKETCH

DESCRIPTION:

A 0.1 ft. diam. disk stamped "50-9"  
set flush in a concrete curbing.

TO REACH:

Go to intersection of SE Douglas Ave.  
and Southern Pacific Railroad.

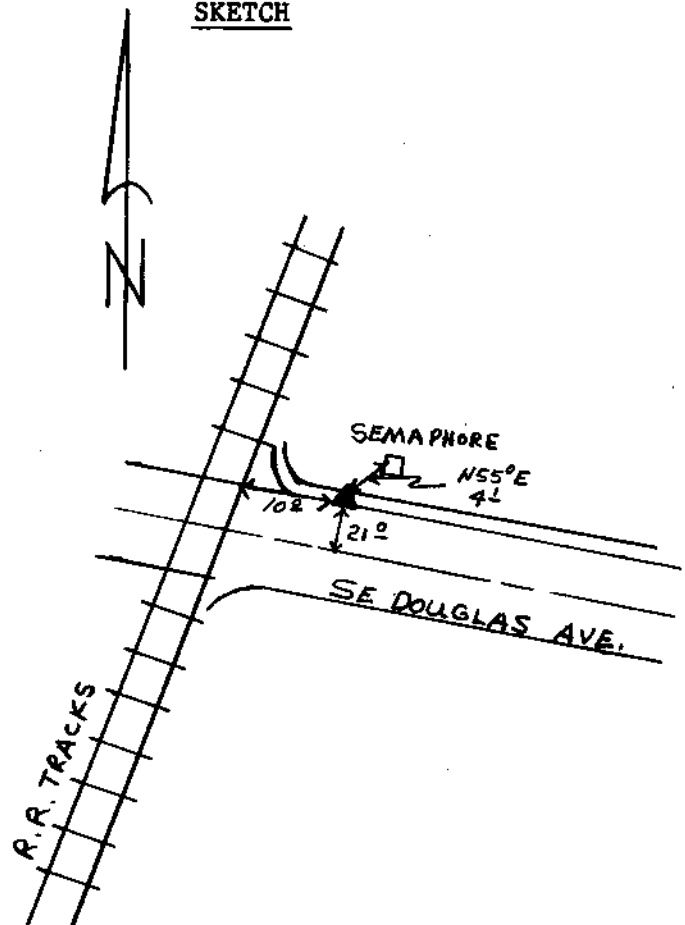

Reference Marks:

Note: For further information, contact the Douglas County Surveyor's Office, Room 205  
Douglas County Justice Building, Roseburg, OR 97470. Phone 440-4278. Douglas  
County residents outside the Roseburg calling area, dial toll free 1-800-452-0991.