

OFFICE OF THE
DOUGLAS COUNTY SURVEYOR

Station: 57-1 T 27 S, R 5 W, Sec 19

Set By (Agency): City (Rsbg.)

Date Set: _____

Recovered By KR.JP


Date Recovered 5/82

Recovered By DCSD 7/98

Date Recovered _____

Recovered By _____

Date Recovered _____

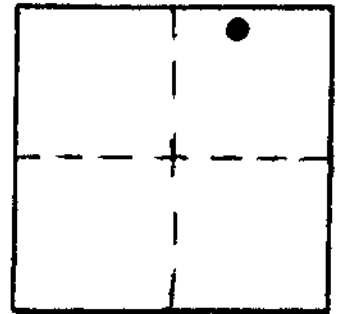

#-039 27S 5W 19
57-1

NAD 576438.50 4166448.42
83 43°12'48" 123°19'56"

VERTICAL CONTROL NGVD 29

Elevation: 458.33 NGS Line # _____ USGS Line # _____ OSHD Line # _____

Precision: 3rd Agency: DCSD Proj. # CS # 06/57 2007 Date: 7/98

HORIZONTAL CONTROL OCS 27

South Zone State Plane Coordinates: Y(Northing) 576,473.73 X(Easting) 1,245,490.12

Precision: 1/20,000 Agency: DCSO Proj. # 2005-2 Date: 1983

Approximate Geographic Position: Latitude 43° 12' 49" Longitude 123° 19' 51"

DESCRIPTION and TO REACH


SKETCH

DESCRIPTION:

A standard City of Roseburg disk stamped "57-1" set in concrete curbing.

TO REACH:

Monument is at the intersection of Diamond Lake Blvd. and N.E. Fulton St.

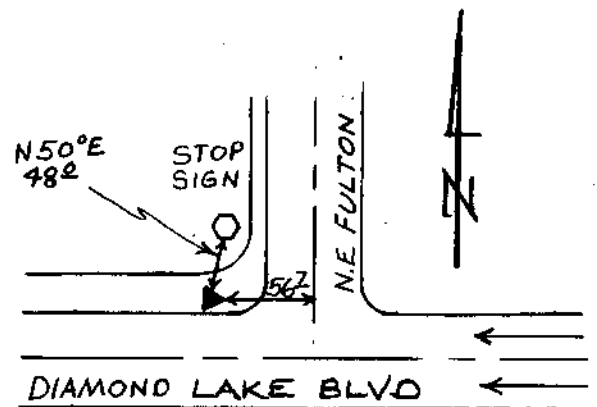

Reference Marks:

Note: For further information, contact the Douglas County Surveyor's Office, Room 205 Douglas County Justice Building, Roseburg, OR 97470. Phone 440-4278. Douglas County residents outside the Roseburg calling area, dial toll free 1-800-452-0991.