

OFFICE OF THE
DOUGLAS COUNTY SURVEYOR




#-069
25-1

275 6W 14

NAD 577303.33 4154709.99
83 43°12'53" 123°22'35"

Station: 25-1 T 27 S, R 6 W , Sec 14
 Set By (Agency): CITY(RSBG)
 Date Set: ?
 Recovered By KR,TP
 Date Recovered 5/82
 Recovered By RWS, SJF
 Date Recovered 2000
 Recovered By _____
 Date Recovered _____

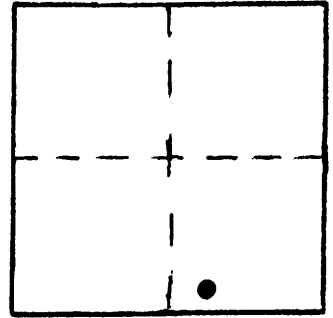

VERTICAL CONTROL NGVD 29

Elevation: 440.69 440.47 NGS Line # _____ USGS Line # _____ OSHD Line # _____
 Precision: 3rd Agency: CITY(RSBG) Proj. # 66/38 Date: 2000

HORIZONTAL CONTROL OCS 27

South Zone State Plane Coordinates: Y(Northing) 577,338.47 X(Easting) 1,233,751.63
 Precision: 1/20,000 Agency: DCSO Proj. # 2005-2 Date: 1983
 Approximate Geographic Position: Latitude 43°12'53.2" Longitude 123°22'30.3"


DESCRIPTION and TO REACH

SKETCH

DESCRIPTION:

A disk stamped "25-1" set flush in concrete sidewalk.

Go to intersection of W. Foothill Dr. and W. Harvard Blvd.

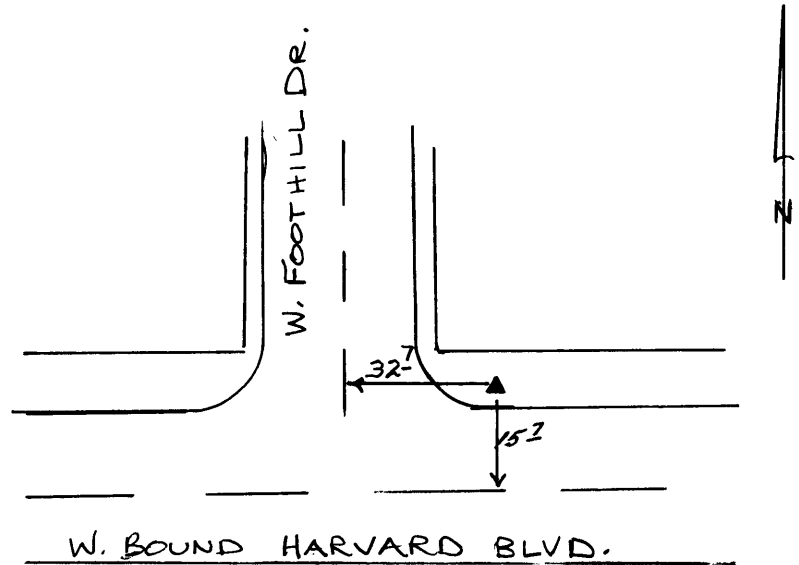

Reference Marks:

Note: For further information, contact the Douglas County Surveyor's Office, Room 205 Douglas County Justice Building, Roseburg, OR 97470. Phone 440-4278. Douglas County residents outside the Roseburg calling area, dial toll free 1-800-452-0991.