

OFFICE OF THE
DOUGLAS COUNTY SURVEYOR

Station: 40-8

T 27 S, R 6 W, Sec 24

Set By (Agency): CITY(RSBG)

Date Set: ?

Recovered By LEM, TRP


Date Recovered 9/81

Recovered By RWS-STF/2000

Date Recovered _____

Recovered By _____

Date Recovered _____

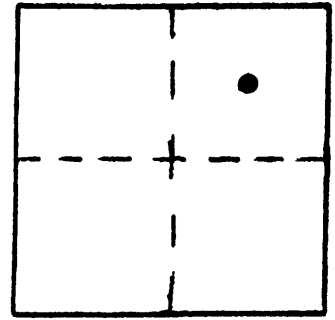

#-094
40-8

27S 6W 24

NAD 574910.58 4160933.09
83 43°12'31" 123°21'9"

VERTICAL CONTROL NGVD 29

Elevation: 453.00 NGS Line # _____ USGS Line # _____ OSHD Line # _____

Precision: 3rd Agency: DCSO Proj. # 66/38 Date: 2000

HORIZONTAL CONTROL OCS 27

South Zone State Plane Coordinates: Y(Northing) 574,945.77 X(Easting) 1,239,974.75

Precision: 1/20,000 Agency: DCSO Proj. # 2005-2 Date: 1983

Approximate Geographic Position: Latitude 43°12'31.6" Longitude 123°21'05.1"

DESCRIPTION and TO REACH


SKETCH

DESCRIPTION:

A 1 1/4 in. diam. disk stamped "40-8"
set flush in concrete curb.

TO REACH:

Go to intersection of SE Mosher Ave.
and SE Fullerton St.

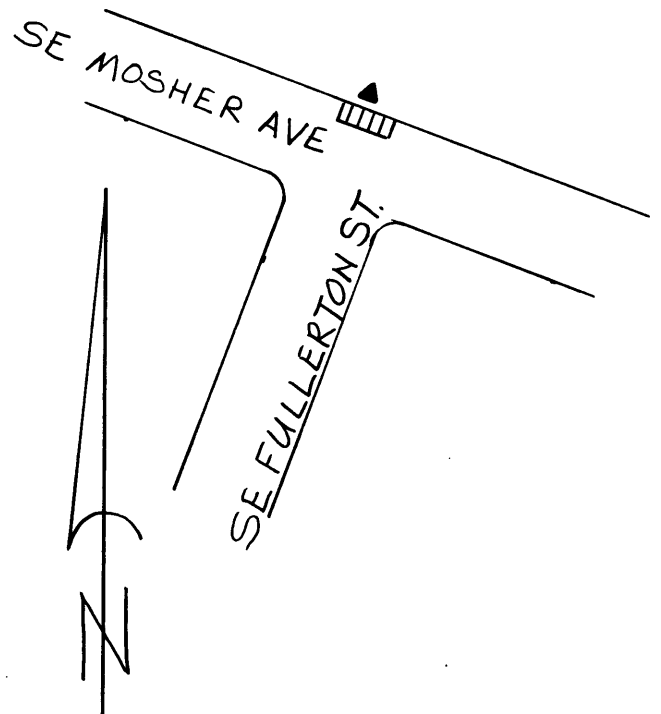

Reference Marks:

Note: For further information, contact the Douglas County Surveyor's Office, Room 205
Douglas County Justice Building, Roseburg, OR 97470. Phone 440-4278. Douglas
County residents outside the Roseburg calling area, dial toll free 1-800-452-0991.