


OFFICE OF THE
DOUGLAS COUNTY SURVEYOR

Station: 41-1 OSHD T 27 S, R 6 W, Sec 24
 Set By (Agency): OSHD
 Date Set: ?
 Recovered By KR, TP
 Date Recovered 5/82
 Recovered By _____
 Date Recovered _____
 Recovered By _____
 Date Recovered _____



#-096 27S 6W 24
41-1 OSHD

NAD 576034.85 4162079.57
83 43°12'43" 123°20'54"

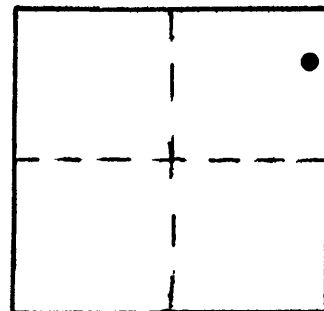

VERTICAL CONTROL

Elevation: _____ NGS Line # _____ USGS Line # _____ OSHD Line # _____
 Precision: _____ Agency: _____ Proj. # _____ Date: _____

HORIZONTAL CONTROL OCS 27

South Zone State Plane Coordinates: Y(Northing) 576,070.05 X(Easting) 1,241,121.25
 Precision: 1/20,000 Agency: DCSO Proj. # 2005-2 Date: 1983
 Approximate Geographic Position: Latitude 43°12'43" Longitude 123°20'50"

DESCRIPTION and TO REACH


DESCRIPTION:

A brass cap stamped "41-1" set in concrete sidewalk of bridge.

TO REACH:

Go to the N'Easterly side of Washington St. bridge over S. Umpqua River.

SKETCH

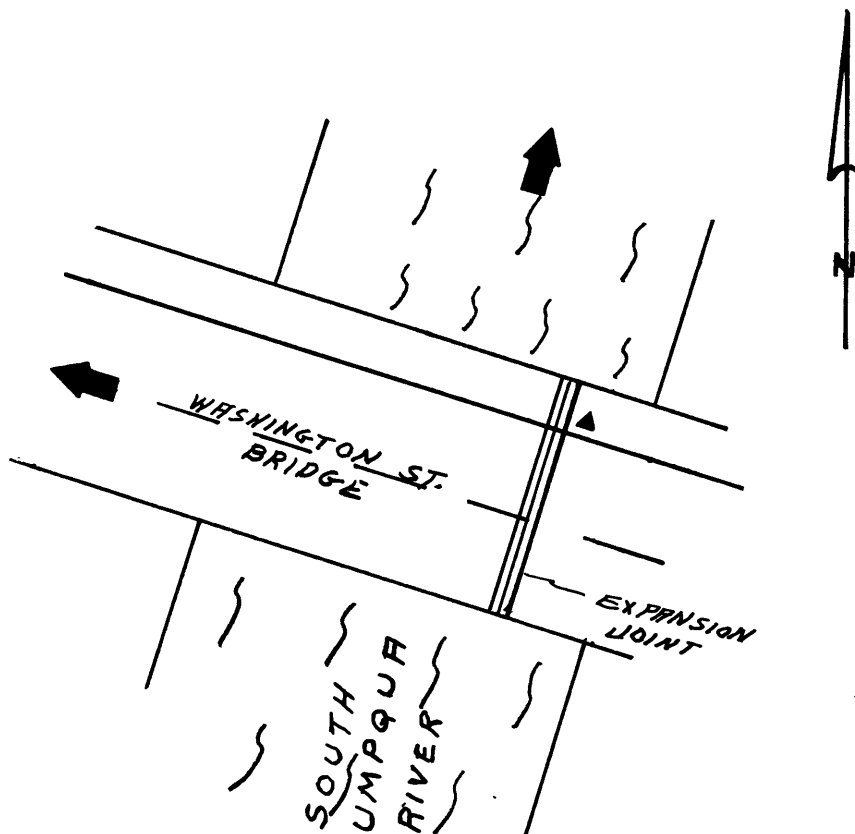

Reference Marks:

Note: For further information, contact the Douglas County Surveyor's Office, Room 205 Douglas County Justice Building, Roseburg, OR 97470. Phone 440-4278. Douglas County residents outside the Roseburg calling area, dial toll free 1-800-452-0991.