

OFFICE OF THE
DOUGLAS COUNTY SURVEYOR

Station: 1 HJH 722 T 29 S, R 5 W , Sec 23

Set By (Agency): IISGS

Date Set: 1953

Recovered By LEM-KR


Date Recovered 4-82

Recovered By 12/92 RWS-SJF

Date Recovered _____

Recovered By _____

Date Recovered _____

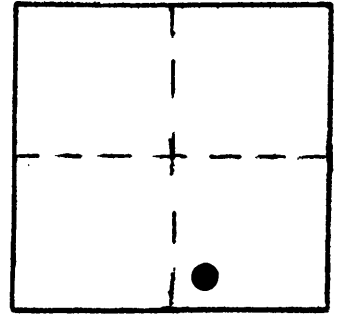

#-105
1 HJH 722

29S 5W 23

NAD 508554.35 4185347.67
83 43° 1' 44" 123° 15' 10"

VERTICAL CONTROL **NGVD 29**

Elevation: 722.055 NGS Line # _____ USGS Line # 145 OSHD Line # _____

Precision: 2nd Order Agency: DCSO Proj. # 2007 Date: 1992

HORIZONTAL CONTROL **OCS 27**

CS-66147

South Zone State Plane Coordinates: Y(Northing) 508,589.97 X(Easting) 1,264,389.21

Precision: 1/25,000 Agency: DCSO Proj. # 2004-16 CS 61/1 Date: 1979


Approximate Geographic Position: Latitude 43° 01' 45" Longitude 123° 15' 06"

DESCRIPTION and TO REACH

SKETCH

The station is a standard USGS disk set in a concrete filled 8" belltile protruding 7" above the ground stamped "1 HJH 722 1953". Disk is approx 2.5 ft. above road surface.

To Reach: At the intersection of Co. Rd. 18 (South Myrtle Rd.) and Co. Rd. 18A in S. 23 T29S, R5W.

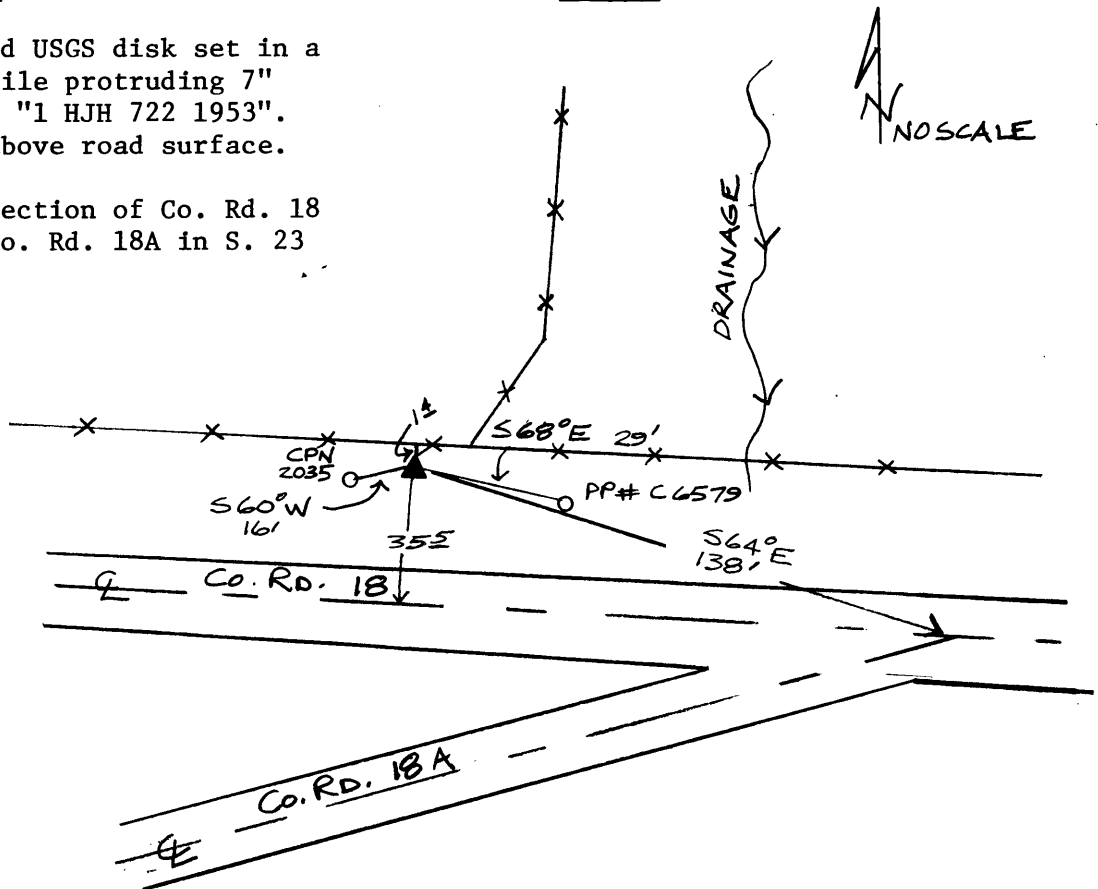

Reference Marks:

Note: For further information, contact the Douglas County Surveyor's Office, Room 205 Douglas County Justice Building, Roseburg, OR 97470. Phone 440-4278. Douglas County residents outside the Roseburg calling area, dial toll free 1-800-452-0991.