



OFFICE OF THE  
DOUGLAS COUNTY SURVEYOR

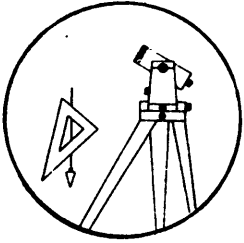

#106

Station: 14M T 29 S, R 3 E, Sec 30  
 Set By (Agency): USGS  
 Date Set: 1944  
 Recovered By SJF, RWS  
 Date Recovered Aug. 14, 1987  
 Recovered By \_\_\_\_\_  
 Date Recovered \_\_\_\_\_  
 Recovered By \_\_\_\_\_  
 Date Recovered \_\_\_\_\_

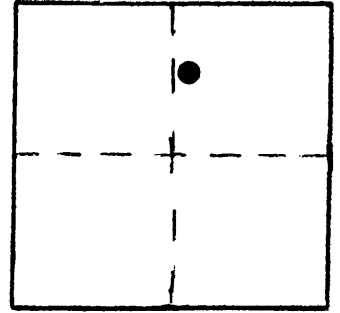

VERTICAL CONTROL NGVD 29

Elevation: 4178.67 ft. NGS Line # \_\_\_\_\_ USGS Line # 143 OSHD Line # \_\_\_\_\_  
 Precision: 3rd. order Agency: USGS Proj. # \_\_\_\_\_ Date: 1965

HORIZONTAL CONTROL

South Zone State Plane Coordinates: Y(Northing) \_\_\_\_\_ X(Easting) \_\_\_\_\_  
 Precision: \_\_\_\_\_ Agency: \_\_\_\_\_ Proj. # \_\_\_\_\_ Date: \_\_\_\_\_  
 Approximate Geographic Position: Latitude \_\_\_\_\_ Longitude \_\_\_\_\_


DESCRIPTION and TO REACH

SKETCH

A 3 1/4 inch diameter U.S.G.S. disk stamped "14M 4179 1944" set in top of 6x4x3 foot high boulder.

TO REACH:

From the intersection of U.S.F.S. Rd. #2947 (400) and spur road 430 in T29S, R3E, Section 30 proceed westerly along spur road 430 approximately 350 feet to monument on left.

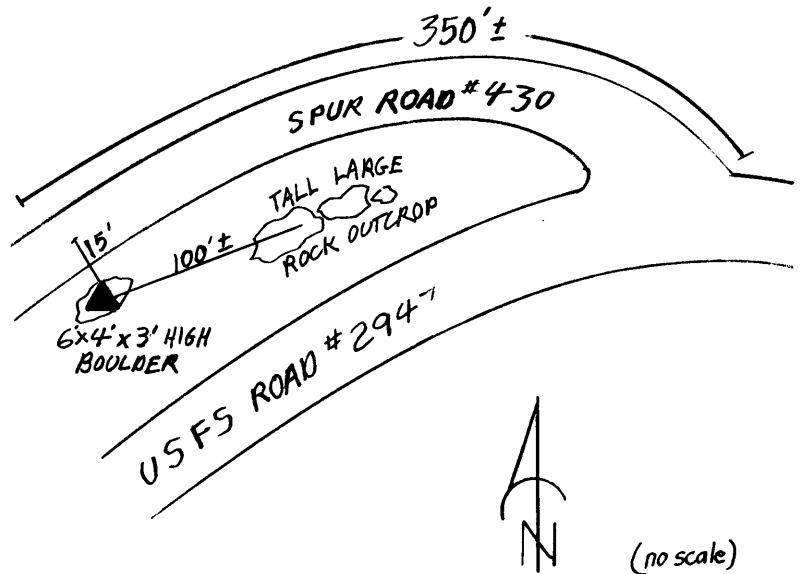

Reference Marks:

Note: For further information, contact the Douglas County Surveyor's Office, Room 205 Douglas County Justice Building, Roseburg, OR 97470. Phone 440-4278. Douglas County residents outside the Roseburg calling area, dial toll free 1-800-452-0991.