


OFFICE OF THE
DOUGLAS COUNTY SURVEYOR



#-116 30S 6W 24
30624 A

NAD 479872.89 4154904.86
83 42°56'51" 123°21'47"

Station: 30624A T 30 S, R 6W , Sec 24
 Set By (Agency): DCSO
 Date Set: 1978
 Recovered By LEM
 Date Recovered 2-82
 Recovered By RWS,SJF
 Date Recovered 10/29/85
 Recovered By _____
 Date Recovered _____

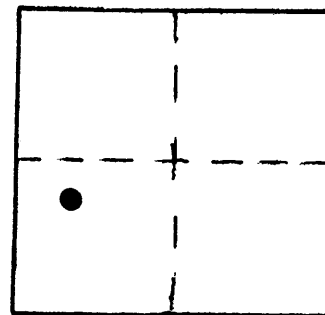

VERTICAL CONTROL NGVD 29

Elevation: 685.303 NGS Line # _____ USGS Line # _____ OSHD Line # _____
 Precision: 2nd Agency: DCSO Proj. # 2013 Date: 1985

HORIZONTAL CONTROL NAD 27


South Zone State Plane Coordinates: Y(Northing) 479,908.55 X(Easting) 1,233,946.33
 Precision: 1/25,000 Agency: DCSO Proj. # 2008 Date: 1978
 Approximate Geographic Position: Latitude 42°56'51" Longitude 123°21'43"

DESCRIPTION and TO REACH

Found: A standard Ore. St. Hwy. Dept. disk stamped "DCSO 30624A 1978". Cap is set in concrete sidewalk 8" above bridge deck.

To reach: Station mark is in Riddle, on bridge over Cow Creek at Southerly end of Main Street.

SKETCH

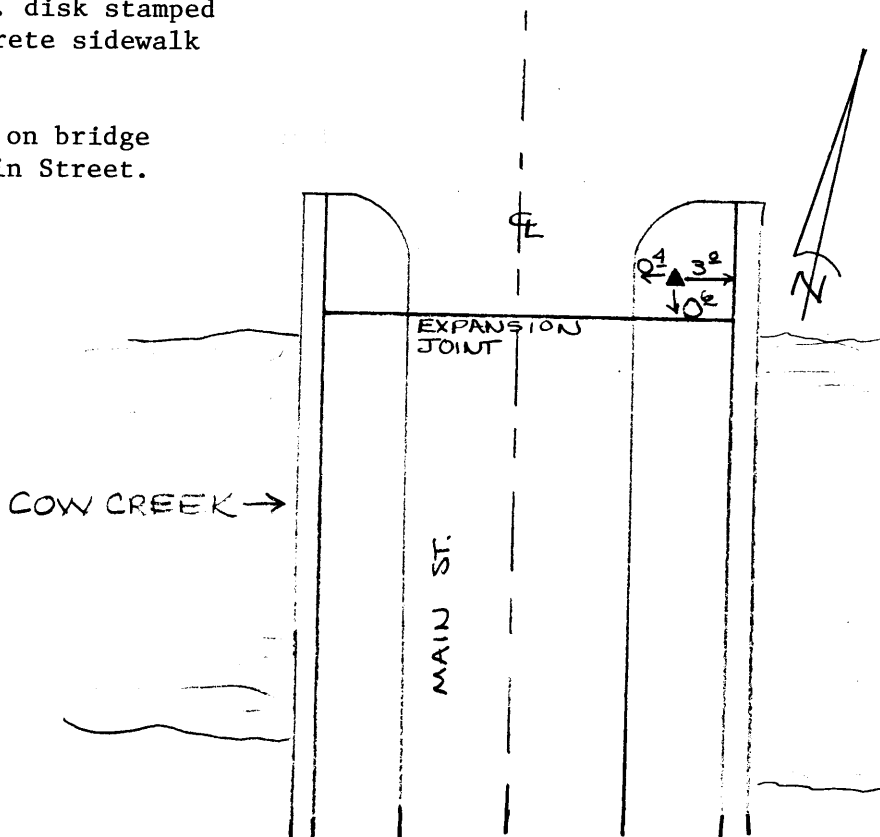

Reference Marks:

Note: For further information, contact the Douglas County Surveyor's Office, Room 205 Douglas County Justice Building, Roseburg, OR 97470. Phone 440-4278. Douglas County residents outside the Roseburg calling area, dial toll free 1-800-452-0991.