
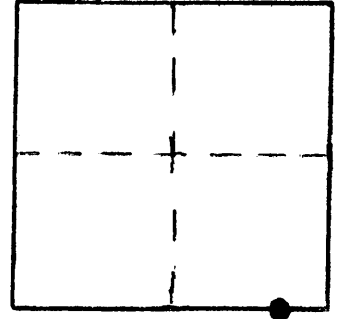


OFFICE OF THE  
DOUGLAS COUNTY SURVEYOR

Station: 16-D16  
 Set By (Agency): BPR  
 Date Set: 1928  
 Recovered By R.S., S.J.F.  
 Date Recovered Feb. 29, 1984  
 Recovered By \_\_\_\_\_  
 Date Recovered \_\_\_\_\_  
 Recovered By \_\_\_\_\_  
 Date Recovered \_\_\_\_\_

T 31 S, R 2 W, Sec 13

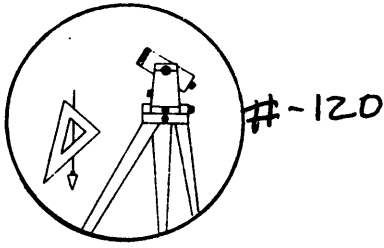

**NGVD 29**

VERTICAL CONTROL

Elevation: 1,429.147 NGS Line # 129 USGS Line # \_\_\_\_\_ OSHD Line # \_\_\_\_\_  
 Precision: 2nd. Agency: USC&GS Proj. # \_\_\_\_\_ Date: 1956

HORIZONTAL CONTROL

South Zone State Plane Coordinates: Y(Northing) \_\_\_\_\_ X(Easting) \_\_\_\_\_  
 Precision: \_\_\_\_\_ Agency: \_\_\_\_\_ Proj. # \_\_\_\_\_ Date: \_\_\_\_\_  
 Approximate Geographic Position: Latitude \_\_\_\_\_ Longitude \_\_\_\_\_

DESCRIPTION and TO REACH

A B.P.R. disk stamped " 16-D16 1928 "  
 set in an 8 inch diameter concrete post pro-  
 truding 2 inches above the ground.


To Reach:

From the intersection of State  
 Highway #227 and U.S.F.S. road #  
 3101 in T31S,R2W,Sec. 13 proceed  
 southeasterly along State Highway  
 #227 approximately 0.6 miles to  
 monument on right.

From the Drew Store on State Highway 227  
 at Drew, IN T31S,R2W,Sec.14, proceed  
 approx. 1.2 miles southeasterly along State  
 Highway 227 to monument on right.

Reference Marks:

SKETCH

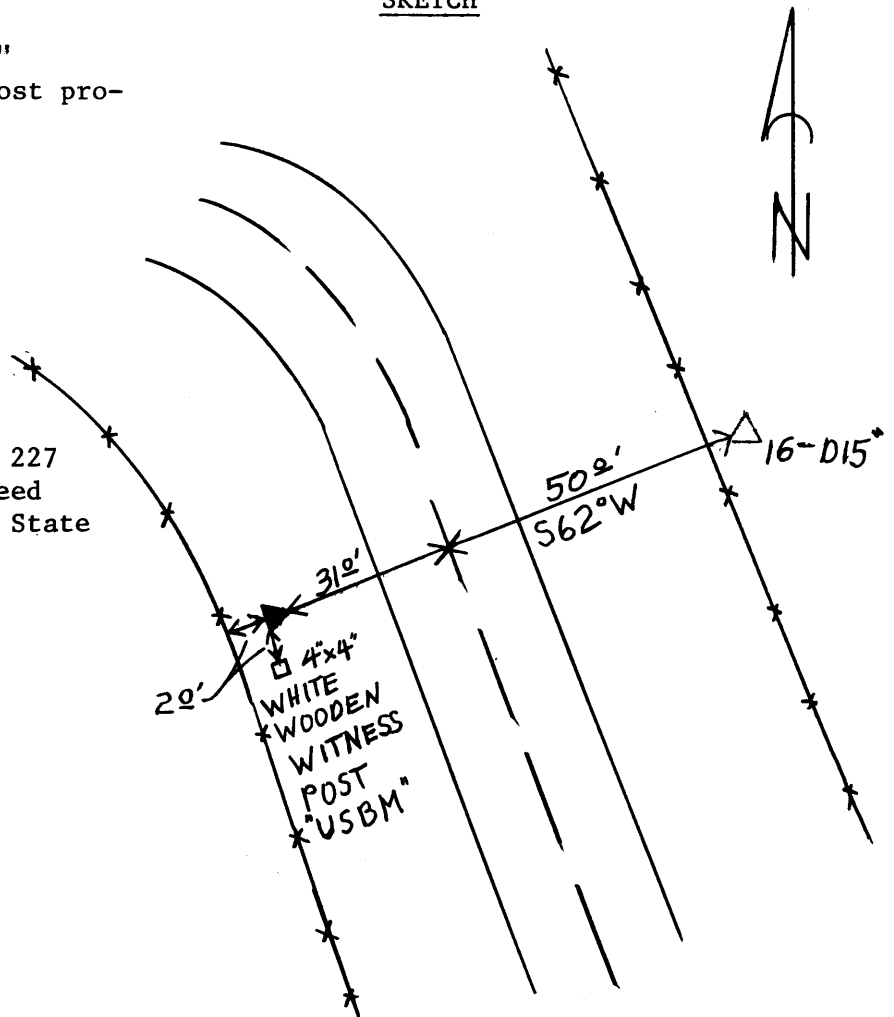

Note: For further information, contact the Douglas County Surveyor's Office, Room 205  
 Douglas County Justice Building, Roseburg, OR 97470. Phone 440-4278. Douglas  
 County residents outside the Roseburg calling area, dial toll free 1-800-452-0991.