



OFFICE OF THE
DOUGLAS COUNTY SURVEYOR

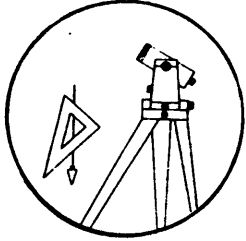

#131

Station: 9 T 29 S, R 4E , Sec 29
Set By (Agency): BPR
Date Set: 1939
Recovered By DCSO
Date Recovered 8-12-86
Recovered By _____
Date Recovered _____
Recovered By _____
Date Recovered _____

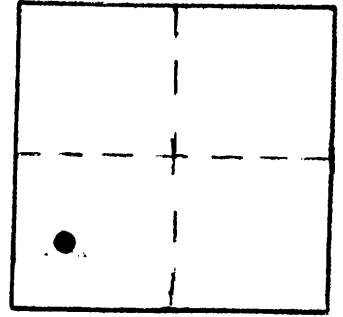

VERTICAL CONTROL NGVD29

Elevation: 3855.701 NGS Line # 128 USGS Line # _____ OSHD Line # _____
Precision: 2nd Agency: USC&GS Proj. # 2013 Date: 1957

HORIZONTAL CONTROL

South Zone State Plane Coordinates: Y(Northing) _____ X(Easting) _____
Precision: _____ Agency: _____ Proj. # _____ Date: _____
Approximate Geographic Position: Latitude _____ Longitude _____


DESCRIPTION and TO REACH

4.7 miles Southwest of the
intersection of the Forest Service
roads 6530 & 6560 with Highway 230.
in T29S,R4E,Sec.3.

SKETCH



Brass Cap in concrete monument,
4" above ground with witness post.

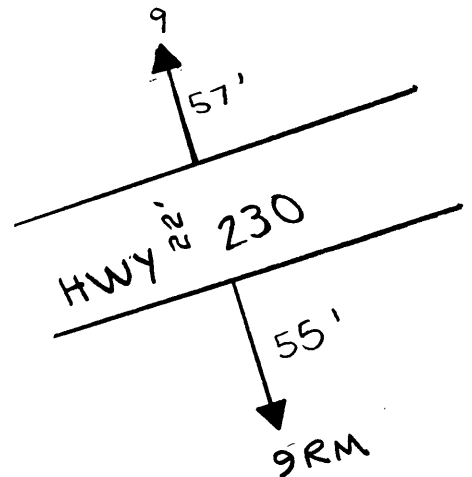

Reference Marks:

Note: For further information, contact the Douglas County Surveyor's Office, Room 205
Douglas County Justice Building, Roseburg, OR 97470. Phone 440-4278. Douglas
County residents outside the Roseburg calling area, dial toll free 1-800-452-0991.