

# Douglas County Geodetic Data Sheet

T 25 R 05 S 04

Station: 454 = Q 266

Designation: %-147

Date Set: 1925 Set By (Agency): USGS

Last Date Recovered: 07/00/1993



## VERTICAL CONTROL

NGVD 29 Elevation: 454.52 Feet

Precision: 1ST ORDER Agency: USC&GS

Project:

Date: 1957

NAVD 88 Elevation: 139.612 Meters

Precision: 1ST ORDER Agency: USGS

Project:

Date: 1988

NGS Line # L25035

USGS Line #

OSHD Line #

File #

## HORIZONTAL CONTROL

OCS 27 Y(Northing): 653,324.51 X(Easting): 1,256,034.22 Lat

Long:

Precision: 1/25,000 Agency: DCSO

Project: 2006

Date: 1981

OCS 83 Y(Northing): 652,289.99 X(Easting): 4,176,993.54 Lat: 43°25'20"

Long: 123°18'08"

Precision: Agency:

Project:

Date:

OCS 83/91 Y(Northing): X(Easting): Lat:

Long:

Precision: Agency:

Project:

Date:

OCS 27 Scaled Latitude: 43°25'32"


OCS 27 Scaled Longitude: 123°18'04"

## DESCRIPTION:

A 3.75 INCH DIAMETER DISK STAMPED; Q 266 454 453.86 1925; SET FLUSH IN CONCRETE CURB OF STATE HWY 99 BRIDGE OVER CALAPOOYA CRK AND SPRR

## COMMENTS:

GO TO THE HWY 99 BRIDGE OVER CALAPOOYA AND SPRR APPROX 0.3 MILES NORTH OF OAKLAND IN T25S R5W SEC 04

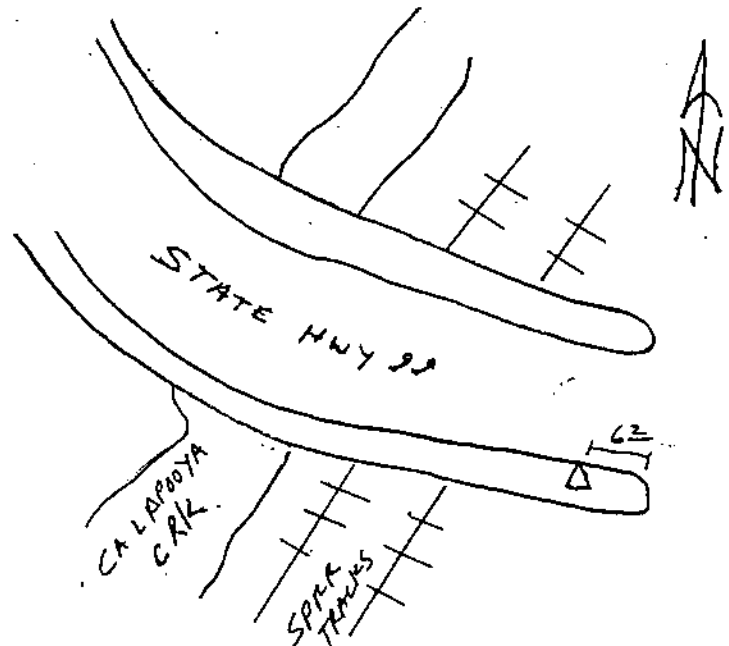

Note: For further information contact the Douglas County Surveyors Office, Room 105A Douglas County Courthouse, Roseburg, OR 97470. Phone 440-4272 or Fax (541)957-8150. Douglas County Residents outside Roseburg calling area, dial toll free 1-800-224-1619.