


OFFICE OF THE
DOUGLAS COUNTY SURVEYOR

Station: 25 M T 26 S, R 3 W, Sec 5
 Set By (Agency): U.S.G.S.
 Date Set: 1935
 Recovered By RS, SJF
 Date Recovered June 20, 1984
 Recovered By _____
 Date Recovered _____
 Recovered By _____
 Date Recovered _____

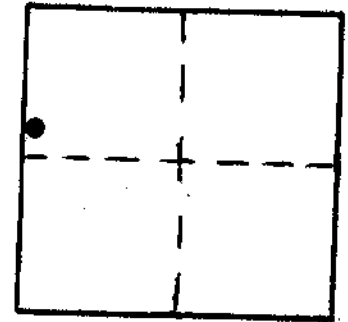

NOT IN
QUAD BOOK

#-160

VERTICAL CONTROL

Elevation: 1242.78 NGS Line # _____ USGS Line # 175 OSHD Line # _____
 Precision: 3rd. Agency: U.S.G.S. Proj. # _____ Date: 1935

HORIZONTAL CONTROL

South Zone State Plane Coordinates: Y(Northing) _____ X(Easting) _____
 Precision: _____ Agency: _____ Proj. # _____ Date: _____
 Approximate Geographic Position: Latitude 43°20'18" Longitude 123°05'18"

DESCRIPTION and TO REACH


A U.S.G.S. disk stamped "25 M 1242 1935" set in an 8 X 8 inch concrete post protruding 8 inches from the ground.

TO REACH:

From the intersection of State Highway 138 and French Creek Road (Co. Rd. #483) in T26S, R3W, Sec. 17 proceed westerly along French Creek Road approximately 0.2 miles to end of county road and the beginning of two ranch roads. Proceed westerly along Stanley ranch road approx. 1.0 miles to a bridge crossing Bradley Creek, proceed northerly after crossing bridge approx. 0.3 miles to barnyard. Thence proceed northeasterly crossing Bradley Creek thence northerly approx. 2.0 miles along unimproved road to monument on right.

Also, from the intersection of an unimproved private ridge-top road and an unimproved private road following Bradley Creek in T26S, R3W, Sec. 5, proceed southerly along Ridge-top rd. approx. 0.1 miles to monument on left.

SKETCH

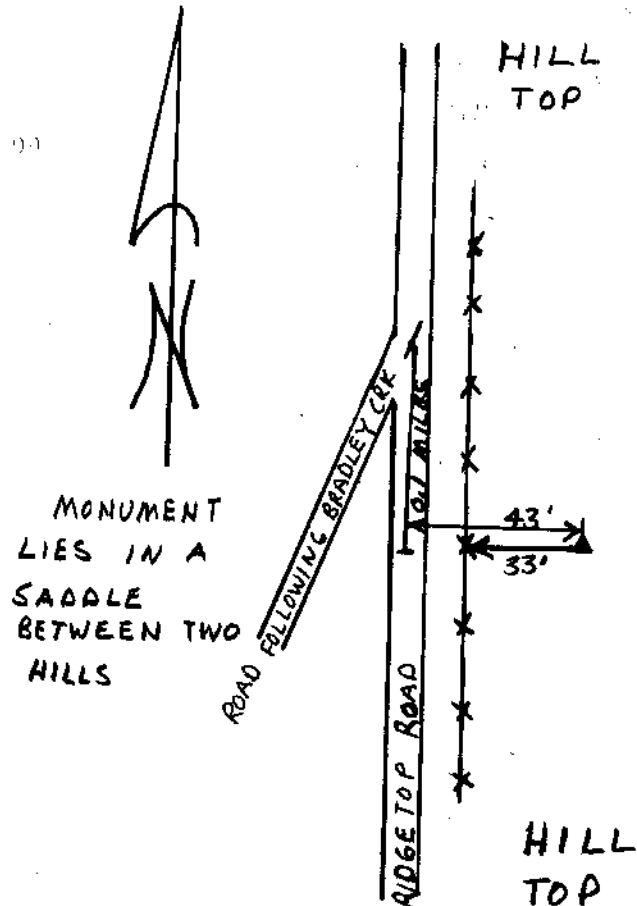

Note: For further information, contact the Douglas County Surveyor's Office, Room 205 Douglas County Justice Building, Roseburg, OR 97470. Phone 440-4278. Douglas County residents outside the Roseburg calling area, dial toll free 1-800-452-0991.