


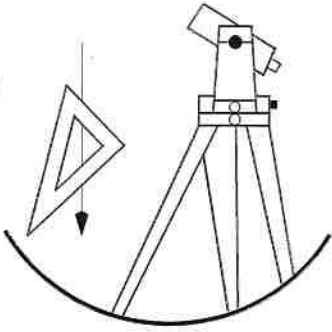

DOUGLAS COUNTY SURVEYOR'S OFFICE

ROMEY WARE, COUNTY SURVEYOR

COURTHOUSE ROOM 105-A
ROSEBURG, OREGON 97470
(541) 440-4272

July 28, 1998

To whom it may concern:

The old Field Books of O.F. Thiel, PLS #4, have been in the office of the County Surveyor for a number of years (the exact number is unknown to me). They have recently be plotted and index cards made for them.

I began going through them in the fall of 1993, when time allowed it. Due to a recent court case it was determined that it was important to plot them the best that we could. Not all of the surveys are plotted, some pages are extemely hard to read, and others are hard to follow.

Jean H. Crawford
Survey Technician
D.C.S.O.

T - R	Sec.	Page	For/Title	Date	T
0-0		3	Jespersion		
T20-2	32 ♥	37	Lane Co. - Wm. Kelley	12/11/28	
T21-4	16 (SE) ♥	36	Martin Anderson	9/13/28	
T21-4	28	33	Bert Delauney	7/21/28	
T21-4	28	43	Benj. Watkins	1/5/30	
T21-4	32 ♥	39 - 40	W.C. Henderer	12/28/28	
T21-5	12 ♥	31 - 32	Pioneer Lumber Co.	4/28	
T21-5	28 ♥	38	Perkins & Beebe	12/13/28	
T21-5	31 (S¼) ♥	51-52	Harry Haines	1/15/31	
T21-5	33	22	Mary Perkins	3/29/27	
T21-5	33	54	Minnie Krewson		
T21-5	35 ♥	20 - 21	N.D. Cool	3/25/27	
T22-3	5	35	Lane Co. - Krewson/Clark	11/15/28	
T22-4	21 & 28 ♥	30	Jas. Cox	11/27	
T22-4	31 & 32 ♥	45	J.G. Applegate	2/3/30	
T22-5	2 ♥	20 - 21	N.D. Cool	3/25/27	
T22-5	3 ♥	4 - 5	N.A. Koepka	8/17/26	
T22-5	4 & 5 ♥	23 - 25	Floyd O. Craig	8/27	
T22-5	6 ♥	51-52	Harry Haines	1/15/31	
T22-5	17	6	H.L. Cowles	8/23/26	
T22-5	31 & 32 ♥	10	Leeper & Ohlson	10/21/26	
T22-5	31 & 32 ♥	18	J.T. Miller & Ohlson	2/16/27	
T22-5	35 & 36 ♥	7 - 8	Cochran Bros	9/23/26	
T22-6	1 ♥	51-52	Harry Haines	1/15/31	
T22-6	24/25 ♥	41 - 42	Whipple & Harlan	2/6/29	
T23-4	? ♥	14	J.A. Forbee		
T23-4	5 & 6 ♥	45	J.G. Applegate	2/3/30	
T23-4	19 & 20 ♥	11 - 13	Pringle Bros.	11/26	
T23-4	19 ♥	19	Ed Douglass	2/7/27	
T23-4	30 & 31 ♥	9	Albert Cochran	9/23/26	
T23-5	2	44	R.W. Davis	7/16/29	
T23-5	5 & 6 ♥	10	Leeper & Ohlson	10/21/26	
T23-5	6 ♥	27 - 29	J.T. Miller's Est.	12/27	
T23-5	24 ♥	19	Ed Douglass	2/7/27	
T23-5	25 & 36 ♥	9	Albert Cochran	9/23/26	
T24-4	9 & 16 ♥	15 - 17	E.A. Davidson	1/27	
T24-4	26 & 27 ♥	26	S.S. Schell	10/13/27	
T24-5	39 DLC	34	E.R. Stevenson	7/28/28	
T25-4	10 ♥	46 - 49	Eliza J. Rone	7 & 9/30	


♥ Denotes Government corners set & BTs marked or re-marked.

♦ Denotes pages that are hard to read or can't be read.

♣ Denotes that the survey is similar to , or the same as the map number given.

This is a rough index for the field book

Field Book #116

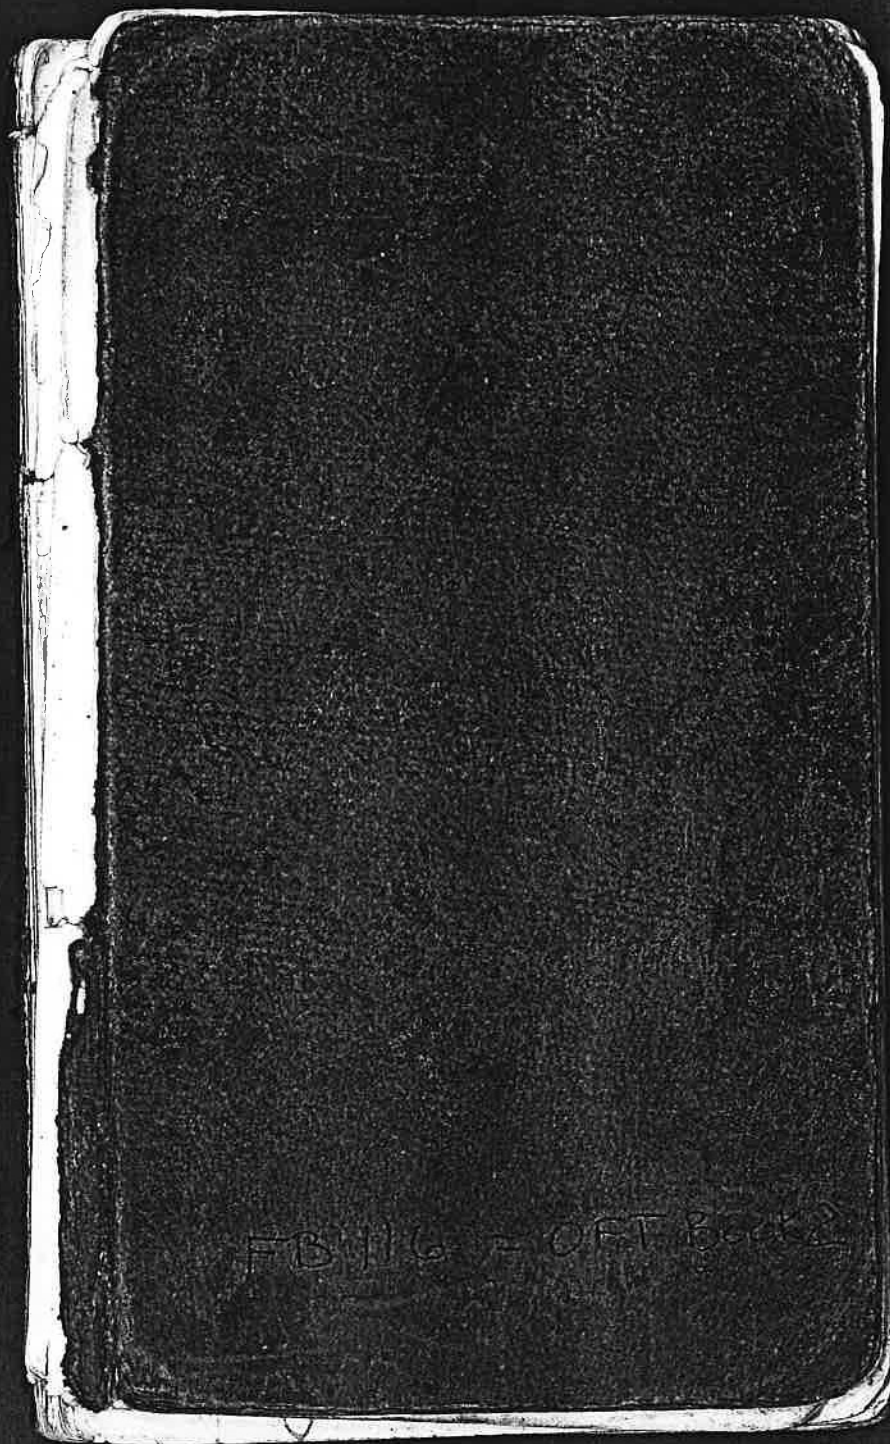

FB 116 - OFF BOOK 2

FB 11 to

Property
of

O. F. Thiel
Surveyor.

Yoncalla, Oregon.

١٠

١٠

J. Jespersen 3

Contd.

Intersect E of 4 cor. 92-
NE tree standing found
old marks.
at 20.30 and 46 mark
red top post.

marked for 8 & 47 N. 09.

" 10 71 56.9 08.

at 19.91. East of the N.E.

cor. of 20 near North.

across field 20.10 post

on steep hillside Run

line and across field

sides interposed everywhere

to the cor. Line runs over

center of Jackson's

house. West of a pond

2000 N. of N.E. cor. of

21 and thence across

pasture to 21 line in-

tersect a little north

of E. & W. line 21.045

of Box old line 21.045

Aug 17th 1926
4th

M.A. Koepke

Beagood, ad. N.E. cor 4
ered 10 16.00 S.R. 5.21
cedar stump box N 76°
17. The 1st from the 1st
2.19 4045 - Entering E
of the cor and

beagood moved back
S 45-10° cedar pack
marked for S 841 N. 26

" 12 N. 48 N. 15

Beagood 16.5 N. 48 N. 15
beagood 16.5 N. 48 N. 15
beagood 16.5 N. 48 N. 15

5

M.A. Koepke Cont.

2.00 cedar pack marked
for. 14 N. 17 E. 19

" 60 " 76 12 35

Each from cor

through timber. rough
20 15 Entering cor. 26

from 4 cor. chained
North along line of corner

corner. 26.00 S.R. pack
marked, dir 16 N. 50 N. 08

cor attached on E slope
from North of a big log.

6

242 Cawla

Aug 23rd 1926.
 Begin at the 4 sec
 cor bet 17.18 2p and 1p
 5th North 133 feet
 209 to base line. N
 along base line 205 N
 9 sec. East 205 to sec line
 from sec line 6.4 base
 208 N North 354 to cor
 East 4.15, then S 63 E
 180, S 85 E, 85 to East line
 of horse land.

7

Cochran Bay

Sept 15th and 23rd 1926.
 Begin at a cedar
 post East (40.00) of the
 4 sec. cor. bet 23rd 34-35.
 2p 22.8 N. 57 chained
 9 from post 40.25 to
 trace of old bearing tree
 to be found. West to
 sec. cor on North S.E.
 bearing tree standing
 (remarked same) stump
 at N.E. and N.W. tree joint.
 10rd a cedar post
 Chained to the South from
 sec. cor. 40.21 set a cedar
 post for cor. marked a
 double cedar 22° S. 68W
 9m. Var. at 4 sec cor. var.
 230.55. Run line chained
 N. to 4 cor.
 From 4 sec cor run E
 Var 23° 05' along N. slope
 dec. 20.10 set a cedar

Path for to cor on N-
slope - marked -
for 40 N 11° E 101.
Maple 12 & 73° W 154
var. at 1/2 cor. 23°

Albert Cochran.
Sept 23rd 1926
Began at the N.E. cor
of Sec. 36 Sp. 22 & 15 W
crossed West from cor
through slashings and
pasture. At the N.E. cor
of 36 cedar post re-
marked N.E. tree a
few rods S.E. stump of
29½ E. marked for 18'
S. 44° E. 63 40.00 no trace
of 4 cor to be found.
Cedar post - marked -
wh. post 18 S 40° E. 35.
at 46 cor E. - marked -
double for 20. S 48° 78.
on line South

Leiper & Chasoon

Oct. 29th 1926

Begin at the 4 sec. cor.
bet secos. 5th 32. or S side
of 32. Sp. 22 S. R. 5 W. cor.
led. by former survey.

Sped. on Sp. line clear
timber intersected a little
S of cor or old post set
by C.S. set a new post
and marked fir 16' N. 76 E

42. run line N. across
valley. Returned to cor.
and run line North
Var. used 21° intersected
N. of cor set. by former
survey. 70 lbs. moved cor
led wt. 70 set a fir post
marked fir 40 N 10 E. 38
" 24 South 12.

Var. used 21° E.

48 00

Poringle Pond.

Nov. 3, 4, 5, 29 1926.

Begin at the S.E. cor of
sec. 19, Tp. 23 S R. 4 W.
S.W. and N.W. tree zone.
set a cedar post.

Var. used 23°

Went from corner.

325 stream C.S.E. steep asc.

2850 top of ridge. C.S.E. N.E.
dead N.W. slope.

40.25 Enter S. of 4 cor. 10.

Sp. tree cut down
Found old marks on N.W.
(opened tree. remarked
same. set a cedar post
and marked a pit. 20 S
84° N. 28.

North from to cor.

Var. used 23° (21 1/2)

along on N.W. slope.

40.25 Enter. N. of cor. 1121

Run E. from cor.

Tringle B. Contd.
Inter. N of 4 cor. 2.33
Set a cedar post at
4 corner.

From 4 cor run W.
from cor. Run line on

Var. 19 $\frac{1}{2}$. Intersect at.

cor. set on N. & S. line, at

40.25 moved temp cor E

1.21 set a grass post and

marked. for 12 N 32° W. 30

Cedar E S 9° E. 19

Var. 2.3° E.

Begin at 4 cor. cor and

traced old line N. to sec.

cor. old post in place trees

standing. Run E from

cor on old line. 20.13 set

cedar post by an old log,

marked a cedar 12.7500 24

" " " 45 S 18° E 38

South from cor.

Var used. 2 1 $\frac{1}{2}$.

Tringle B. Contd.
through heavy timber

40.25 set temp cor on plat.

Begin at 4 cor run

sub E.

18.27 Int. N. of temp cor. 08

Moved temp cor East

1.76 and set a cedar post

marked. for 48 S 73° W. 20

" " " 8 73° W. 27

Begin at cor in

center of sec 19 run

W. var used 19 $\frac{1}{2}$ - at

stake, marked

an alder 10 S. E. 10

maple 12 N. E. 30.

2013

\$ 17.00

15.00

2.00

28

due

J. A. Froebel
Tp. 23 S. R. 4 W.

Began at N.E. cor of sec'd
land. marked.

fir 12" N 78 $\frac{1}{2}$ W. 15
" 12" " 7 E. 07

South from cor.
N.E. by line S. 20° 35'

N. side of R. of W. of Co. road.
5.29 S. 59 $\frac{1}{2}$ ° W. 3.78 West 3.93.

S. 85° W. 3.82 to E. side of
old Co. road. N 12 $\frac{1}{2}$ ° W. 5.12
N. 37 $\frac{1}{2}$ ° W. 3.60 to line fence.

cedar feet marked. 1.63
cedar 15' S 79° E 10.5.
" fir 18' S 1° W

2/3 gr. 20° 35' E.
Chained W. from to cor on
hill 6.43, S. 13.42 to line fence
E to N.E.

(Froebel's N. line) 7.00 E to N.E.
cor. and should be 6.48
Beginning
to cor be 16.4 H.
S. 42° S 5.76 E
10.

E. A. Igrison
Tp. 24 S. R. 4 W.

Began at the 4 sec cor
bet 9-16 sec oak post.

by N.E. bearing tree
(trapele remanded) marked
a cedar 10 S 85° E. 30

South. Var. 21°
sec oak post from which
fir 18' N. 57° E. 15

oak oak 5' S 62° W 10.
East from cor. 600 ft from
C.S. very steep asl. 22.50
set stake, did not run
this line any further.

Jan. 26 & 27 92.7
Began at 4 cor bet 15-16
marks on N.E. tree

N.W. tree fallen
North Var 21°
very steep asl 12.25
top of ridge, along on

16

Jarvison Contd.
 N. slope 20.10 fir stake
 marked fir 24 N 77 E 34
 " 24 S. 9 E. 55
 followed old blazed line

Begin at 4 cor run
 East from cor. desc. along
 through open. 20.50 top of
 ridge 31.40 stream C.S. of
 37.60 stream C.S. 40.00 top
 cor. heavy timber
 fir stake on top of ridge
 marked.

60.30

fir 12 S 45 W. 34
 wh fir 18 N 77 E 26
 South var 21°
 steep and brushy desc.
 stake edge of opening,
 East. steep face.

12.50
N.

14.53 to N.E. cor of cl. 46 m.
 traversed at corner S.W.
 tree dead but standing.

17

Jarvison Contd.
 Laurel N.E. 45 lbs.
 marked fir 18" nail 95
 corner stands E of top
 of ridge
 of South. var 21. desc.
 stake on steep hill side.
 went to S.E. cor of cl.
 a fir 18" in diam stands
 at corner. Two N.E.
 trees standing S.W.
 going.

7.50

Returned to stake on
 hill ext. 12.50 S. of 76 cor.
 and run line South
 through opening to line
 of blaim. dig not
 again this line.

5.11
 18.50

J. J. Miller & Chas. W.
Sp. 23 S. R. 5 W.
Feb. 16th 1927.

Begin at S.W. cor. of sec 32
cut in place.

Northy Var. used 21°.

Sp on hill stream W.

Top of ridge

Black oak post from which

dir 10° N 17° W. 28 lks

Laurel 6" N. 88° E. 13"

that var 21° desc.

stream South acc.

larger fir thr.

top dec oak good top

20.00 oak post in ravine.

marked 100'

wh. oak 12 N. 83 E. 13 lks.

North from cor.

Run line North to top

of ridge. did not chain

\$8.50

Ed. Longlass. Var.
Sp. 23 S. R. 4 W. 1920
Feb. 7th 1927.

Begin at 76 cor. post by
the Pringle Survey.

steep asc. 2.00 top desc.

stream 12 W. C. S. R. acc.

steep asc. E. slope.

Sp. line. Intersected

135° North of 4 cor.

S.E. bearing tree gone but

a young fir in place of

old. marked the new

tree.

West from 4 cor. did

not chain Var used

202. Run to creek.

N. D. Coal

Feb. 22 S R 5 W
 March 25th 1927.
 Begin at 4 sec. cor bed
 2 and 3. Var. 21 1/2°
 East from cor.
 20.12 set a maple post. marked.
 a maple 12" N. 48° W. 12
 South from cor.
 sec fir timber

20.12 set fir post on top of ridge
 marked fir 16" N 32° E 27.
 " 24 S 59° W. 106.
 Begin at N.E. cor. of sec 2.
 post. in place. West from cor.
 Var. used. 22°

13.70 stream c. n. young fir.
 20.12 cedar post on flat
 marked fir 36 N 10 W. 27
 " 10 S 27 E 15

48 00

N. D. Coal Contd.

March 28th -
 from 76 cor on Sp. line
 South from cor. Var 21 1/2°
 sec. small fir str-
 set stake - marked -
 bl. oak 30" S 77 W. 83
 a fir 10 " 5 1/2 E. 25.
 cor stand near top ridge
 Run South, enter larger
 str - did not chain this 40.00.
 divide bed. Elk Pass creek.
 Head to 76 cor 40.00 West
 and run East, did not
 chain at intersection of N. 12.
 line set fir post - marked
 fir 46" S 58° E .14
 " " N. 48 W. .21
 Cor stands on S.E. slope
 at 76 cor E. of 76 cor Run
 North Var 29 1/4°. 45 stream c. N.E.
 20.15 76 cor per stake - marked -
 wh. fir 12" N 18 E .16
 " 5 S 20 W 17.80

35.00

Mary Perkins

H. 2.1° S. R. 5 W.

March. 24th. 1927.

Begin at 1/2 cor. N. of
4th. 33 E. 94.

Run N 89 1/2 W. var.

used. 21° followed old
blazed. of line
ground. post. at
40.00. - thence

South from cor.
Var 21°. Run South
to line fence between
Perkins & Tracy. In-
tersected East of wire
fence. of. leave timber.

\$5.00

Floyd O. Cozig

H. 2.2 S. R. 5 W.

Aug. 18, 19, 20, 22, 23, 25, 27.

Begin at S. 1/2 cor. of 4

re-marked. N. 1/2. tree

cor. at place by C.S.

Var. 21° 35' North 1° E

from cor. and steep up

hill side 15.00 top 20.18

each post marked a

double maple S 20° E. 22.

E and S. of stake set by C.S.

Run N 89 1/2 W.

500 top along N. slope.

22.00 top of divide. N. 1/2. S. E.

60.00 stone in mound of

stone. (in canyon)

marked cedar N. 1/2. S.

to S. 1/2.

N. 1° E. from cor.

steep and. 10.80 top.

marked. 1st post.

marked. 2nd maple. 18" N. 1/2. S.

W. 14, made 20 S. 79 E. 15

4.00

Craig Contd.
Begin at 4 cor. tree
546 both trees standing
cut into NE tree
Run E. from cor. 585
top along S. slope very
steep, like to ~~cor~~ line
N. & S line.

18.65

From this line, the line
E to 4 cor on East, on top
of mountain is S 87½ E.
Chained N. from this line
20.00 set post.

20.00

Run line S 89½ E to
¼ cor. Inter N. of cor. 124
corrected line back to cor.

Begin at S.W. cor. 4
Run S 89° E. and Inter.
S of 4 cor. 24. Iron bolt
in place NW tree stand-
ing
moved to cor E. 20 and

4038

Craig Contd.
North 12 set a sawed
post marked. —
with oak 8" S 64½ E 47
dir 20° N 7½ W 92
North from 76 cor. a/c.
20.00 Lumpy cor.
chained on N. across
pasture to E. ed line.
Thomp stakes.
Went to 4 cor. say full
and chained along line
East 19.58 Inter. N. S line
60 S. at. E
19.70 and 21 E set stakes
and marked a
maple 8" N. 2.

20.00

39.50

S. S. Schell

Oct. 13th. 1927

Tp. 24 S. R. 4 W.

Begin ab 4 cor bet sec

26 & 27 found stumps of m

E. tree and S. W. (a fir) stand-

ing. remarked both trees.

North from cor. desc. var.

used 20° 45'

40.30 no trace of old trees to be

found. Oh old post found

East of line along will fence.

Returned to 4 post and run

S. ave. Var. used 120'

11.50 top of ridge & desc

20.05 Intersect E. of stone cor. 24

Ran W. from cor

2000 temp cor

Went to 76 cor on the South

Var. 20' over broken country.

Inter E. of temp. 9 lks.

19.54 from E. set a fir post for ex.

19.91

J. J. Miller's Co. 1927

Nov. 23rd sec 1st and

Tp. 22 S. R. 5 W.

Begin at the S. W. cor of

sec 32.

Went on Tp. line var.

used 21° 14' 15" temp cor

Begin ab bearing tree

at the 4 cor of sec 16 and

run Tp. line East 5.87 +

1413. Intersected North of

temp stake, 35' moved

stake South. 17 1/2' near

Willow bearing tree mark

ed. E. S.

Dec. 10th

Begin at the center of

sec 6. Found stump of

bearing tree to cor cyl.

down & re-established

cor. by setting a cedar

post (found old stake)

marked a new bearing

J. J. Miller's East Contd.

a fir 28" brs. N 11° W.

85' Var. used 24°

Run N. 89½° E.

14.35 Center of Co. road C. N. S. S.

18.25 " of creek C. N.

20.00 Temp cor in field.

39.87 Entrench N. of 49 cor 12

old stake in place.

both old trees gone.

marked a bl oak 40 S. 86

W. 16 links. (cor stand

on top of ridge)

1993 moved temp cor S. of

marked.

wh. oak 24 N. 45 W. 99

" " 24 S. 16½ E. 98

Begin on section line
at the intersection of S
line of claim N. 49
along wire fence

20.00 run South 9.90 and

J. J. Miller's East Contd.

Hex 179 to wire fence.

corner in prairie field.

20.40 Entrench East. of Cor. 22.

at this corner marked

a fir 28" S. 23 E. 98

" " 20 N. 62 W. 98

Var. used on this line 19°

corner stands on E. slope

Jas. Cox

Nov. 4th 1927.

Sp. 22 S R. 4 W.

Begin at a stake
set 10.00 W. of 4 sec. cor.
on north side of 28 sec
by Stephenson's Survey.

at jaw post.

dist 5 W. W. 3.

South from corner

Var used 22° arc.

dir post marked.

dir 45" W 10' W 18

" 36 S 1 1/2 W. 60.

S. 89 1/2 W. along N. edge

10.00 cedar post marked

dir 16 N 76 W. 10

" 20 S 40 E 08 1/2

Pioneer Lumber Co

Apr. 9th and 13th 1928.

Sp. 21 S R. 5 W.

Begin at the S.E. cor.

set sec. 12. post in place

set by former survey.

2nd post used 2 1/2°

Run west on line

line, appearance & bear a

little South.

39.94 1/4 cor. set a fir post

remarked both old trees.

from 4 cor W. seems to fall

low old tiny

80.42. Dist. 4 lbs S. of cor.

North from cor. decr 11' 30

Var. used 2 1/4° from 11' 30

E. followed old blazed line

39.86 old blazed line E 1/4 cor

48 cor. stands N. of blazed line

Set a fir post and

remarked N.E. tree S.W.

tree dead.

Pioneer L. Co. Contos
from the E cor run
East. Var. used. 2 1/4.

old growth timber

7900 stream 5' C. M.

46.25 ext a fir post.

marked a fir 24' N. 47'

E. 39 lbs.

fir 5" West 5 lbs.

continued fine E cor.

with out. chaining

and intersected E cor.

24 lbs. S. at cor.

timber - 2nd brush.

Wm. Zuperserly
W. V. Chapman say

Bert Delaney
July 2nd 1928

7/2/28 SR 400

Began at the S.E. cor of

the S.W. 1/4 of N. 1/4 of

sec 28. from which a

log was 10' S 7 1/2' N. 73

North from cor.

Var. used 20 3/4

675 stream 15' W. C. W.

867 to center of Co. road

marked cedar. 10 N 21' W. 38

double cedar 18 N 41 1/2' E 71.

S 64° E 873 S 44 1/2' E 657 to

line S 89° W. 1244

beginning

E. R. Stevenson
July 28th 1928
Tp. 24 S R. 5 W.

Begin at a stone at
S.E. cor. of N. & Allen
Rd. No. 39. A wh oak 16"

stands S.W. from stone
marked by E. S.

Run S. 89° E. along wire
fence. Var used 20³¹/₁₆
E. side of Pacific High.
way R. 5¹⁴/₁₆ Ed.

620 ed a fir post. marked
wh. oak 8" N. 27 W. 19

North from cor in pine
stake. N. 89¹⁴/₁₆ W.

to Right-4-way.
along R. & Ward S.W.

S 28° W. 300' S 23° W 190

S 12¹/₂° W. 286' to cor.
containing 3.60 acres.

O. L. Kresvogn and
J. D. W. Beg. Clark
July 22 S. R. 3 W.

Nov. 15th 1928.

Beginning at stone ^{on the}
side of section 5¹⁴/₁₆ cor. by
E. S. Run East 2000.

South 2000. East 2000 to
blazed line running N. S.
set fir stakes at all corners
but did not mark any
bearing trees

marked off. 4 and 2 acre
tract. 4 acre for Kresvogn
and 2 acre for Leo. Clark
Var. used. 21°

at the beginning point
a stone is ground a fir
stump 8¹⁴/₁₆ (45 in) N. 52° E.
57 lbs.

4 acres lies in a square
and 2" " on W.

Martin Anderson

Sp. 21 S. R. 4 W.
Sept. 13th 1928

Begin at the N.E. of sec.
16. found marks on N.E.
stump and S.E. tree (dead
marked).

hemlock. 22" N 11° W. 10

dir 8" S. 24 E. 42.

This cor is S. of the Pacific

Highway about 2.50 on

N slope of hill.

Run the line North from

Cor. RR fence.

Wm. Kelly

Sp. 20 S. R. 2 W.

in sec. 32. Dec. 11th 1928.

Begin at a point on S.
side of section 32. At this
point the old bearing for
the 4 cor. Feb. 5-32 are gone.

found holes in ground
corresponding to description
and direction in field notes
set stone in place.

North from cor. Varied 21°

Interior cor of cl. 38 W. 18.

12.3, set claim cor by N. 18.
bearing tree

North end Howe River

Center of highway N.W. SE

set stake in place

771

31.68

23.10

40.00

Parkins & Beebe

Feb. 21 S. R. 5 W.
Dec. 12-13th 1928.

Begin at 1/4 cor. bet.
28 & 29 both old trees
dead. N.E. cut down &
N. W. fallen. found
old marks on both. Turn
set a cedar post
and marked.

a cedar 18" N. 86° W. 22

a fir 22" " 18 1/2° E 29.

Run East. Var. used 2"
followed old blazed line

at 40.00 Cedar post

remarked S. & trees

maple 8" S. 35° E. 39.

cedar 12" S. 24 W. 14.

This tree has (maple) S 7 E 31

Survey for J. L. Johnson

part 26th 1900.

W. L. Henderson

Dec. 28th 1928.

Feb. 21 S. R. 4 W.

Begin at a post for the
1/4 cor. on S. side of sec. 32.
on W. side of hill.

North door cor. Var 20 3/4
desc. through fir timber

20.10 set a cedar post and

N.E. of a spring - and -
marked.

a cedar 24" N. 73° W. 22

a fir 19" S. 49° E. 15 1/2

ascend along on W. hill

side, very steep.

40.20 set a cedar post and

marked a fir 30" S. 3° E. 29

cor. stands North of pole line

Run S. 89 1/2° W. through opening

20.10 set a cedar post marked

a fir 15" S. 55° E. 16

This cor stands 50 East

of Co. road & South Valley

J. L. Henderson Contd.
South from 76 cor.

2.93	Center of Co. road, thence S 26° E.	4.20
"	3 "	1.93
"	43 "	2.33
"	23 "	3.75
"	1 1/2 "	4.80
"	7 1/2 W	3.32
"	26 "	1.27
"	15 1/2 E	2.00
"	6 1/2 "	6.00
"	44 "	4.00
"	22 1/2 "	2.34
"	45 1/2 "	2.87
"	21 "	2.50

to see line
to cor is East 8.45
Meanders of Co. road

Whipple & Starland
Feb. 4, 5 and 6 1909.
The ad. S R 6, E.

Begin at the S.E. corner
of sec. 24 set an oak post
All old trees standing
Run line west from cor.
dece. through pasture.

12.00	Railroad cor. to " "
18.34	center of County Road. W. N. S.
29.84	Temp corner.
33.00	Top of ridge.
40.10	Intersect S. of 4 cor. 136
	S.E. bearing tree standing set dogwood post.

17.50 From S.E. of 24 West.
moved cor North on true
line set with oak post
marked

for 12 S. 80 W. 7
" 10 East 6
at 76 cor W. of this cor.

Whipple & Gaslam both
set oak post marked
cedar. 22" N. 24 W. 4
wh. oak 10" S. 20 E. 11

Benny Watkins
Sept. 4-5-1930.
Tp. 21 S R 4 W.

Begin at the S.W. cor. of
sec. 28. Old post set. by
E. S. but no trace of any
old bearing trees to be found.
Run East. from cor Var 21° E
along on S. slope. 17.00 top of
ridge. 20.00 temp cor along N.
slope 39.82 enter old post 106
North. West to a cor. post
set for J. B. N. Strick survey.
N.W. cor of S.E. 1/4 of S.E. 1/4 of S.E.
chained W along fence. 20.00
to stake. South. fr. line of
stake to old cor. 20.00 to old
cor. Set a pin post 9 lks E
of old stake 3/4 E of a fir stump
76 cor. West of 76 cor moved.
Temp cor. S. 53 and wh. pin
post for 76 cor corrected line W.

R. W. Davis.
 July 16th. 1929.
 Begun at the N.E. cor of
 Colman Don. (stone at cor.
 of fence on bank of ditch
 East from cor. 4.58
 North from peg across field
 10.75 stream C. W. 19.38
 peg on fence. & N. side of road.

The description reads.

East,	4.58
North-	19.38
869 1/2 W.	19.58
" 44 1/4 "	17.50
East	26.00

Co road.

" 36.90 acres.
 Twp. 23 S. R. 5 W.

J. S. Applgate
 Feb. 3rd. 1930.
 Twp. 23 S. R. 4 W.
 At the N.E. corner of sec-
 tion 6. set a cedar stake
 and marked.
 An ash. 12" South 47 lbs.
 " " 12 1/2 30° E. 39 "
 all of the original trees
 gone. This for re-establish
 old. from bearing trees
 marked by a former
 survey dated Mar. 7th 1906
 where old marks on S. E. tree
 or log were found.
 a first tree marked as a
 witness tree for this cor.
 burnt down.
 Staked line across
 field to East line.

Elija J Rone

July 1, 23, 13th.

Sept 23, 26 & 1930

Tp. 25 S. R. 4 W.

Begin in at N.E. cor of sec

10 Tp 25 S R. 4 W.

old rock and stone for cor.

Marked new trees

fir 30 S 70 E.

" 32 " 79 W

" 20 " 11 "

" 12 " 57 E

South from cor

Var sided 20 $\frac{1}{2}$ E

2.00 to of ridge due

1900 leave timber

20.50 begin steep desc.

27.65 wire fence

27.85 stake in field

N 89 $\frac{1}{4}$ E.

13.04 claim cor. old bearing

tree gone marked

bl. oak 15" N.E. 05

" " 20 " 87 W 90

Rone Counted

East from E.L. cor. 4.00

South 1.62

Ecos. along old fence.

cedar stake marked

wh. oak 7. N. 12 W. 16 $\frac{1}{2}$ Eas. 168 $\frac{1}{2}$ cedar stake

marked. fir 24 S 14 E. 03

" bl oak 6" N 77 W 14 $\frac{1}{2}$

N. 40° 45' E.

top of rise 505 grain field

2.142 stake in grain field

Var. 20 $\frac{1}{2}$ West from 1/4 cor brk 3-10

2.50 South. 10.71 East 2.50 to line

South. 92. N 41° 3/4 E. 1.09

" 33° 20' E. 1290 water edge.

Begin on line witnessed by

fir 24 S 14 E. 03 bl oak 6" N 77 W 14 $\frac{1}{2}$

to West bank of creek.

Marked wh oak 6" N. 84 W 24.

" " 12° N 9 " 23

cor. stands N. of water edge.

Rone Contd.

July 13th. 1930

South fork & cor. 10.71 kamps peg.
 Run line South to S. valley.
 Intersected N. of cor. 19.

9/28-30

Begin at stake on W side of
 creek

N. 42 $\frac{3}{4}$ E.	666 cor. to E	100
" 47 $\frac{1}{2}$ "	170 " "	110
" 35 $\frac{1}{2}$ "	306 " "	20
" 6 $\frac{1}{2}$ W	308 " "	15
" 5 $\frac{1}{2}$ E.	220 " "	20
" 12 $\frac{1}{2}$ W.	237 " "	10
" 38 $\frac{3}{4}$ "	231 " "	65
" 13 E.	92 " "	15
" 8 W.	238 " "	35
" 36 $\frac{3}{4}$ "	142 " "	75
" 66 "	163 " "	125
" 86 "	132 " "	50
" 56 "	248 to cor.	

At this cor set ash stake marked
 double alder 12" S. 77 E. 19

Balm 18' N. 74° W. 52 $\frac{1}{2}$

Rone Contd.

N. 40° - 40' E

+ 41 = 21.83. N. 49° 20' W. 473
 N. 40° 40' E. 7.39 to N. S. line. or
 to cor witnessed by bearing trees.
 Begin at the above corner
 run S. 306 to a point from
 which an ash 17 ft. West. 02

S. 65 $\frac{1}{2}$ E.	4.77 cedar stake.
" 19' "	214 dig 12"
" 5' "	633 birch oak 8"
" 26' W.	222 " " 8"
" 71' E	324 ash 12"

75 further to center of creek.
 ash 12" for bearing tree. marked
 S. B.T. old weed side of creek.

Harry Haines

Jan 14 - 15th 1931.

Sp. 22 S. R. 5 W.

Begin at S.W. cor of sec 6
both old trees gone. Found
marks on N.E. flag.

There seems to be a difference
in the bearing and distance
of the old trees. (rock corner)
Run East from this corner
Var. used. 26 1/2 seem to follow
old blazed line 41.66. intersected
S. of 1/4 cor. 02. set a fir post and
re-marked both old trees. cor
stands on S. slope

North from 1/4 cor. steep asc.
top of ridge, steep desc.

275

1270

bottom of canyon from here.
run line north 30' E. without
chaining to North line intersected
E. 1/4 line. 36 West. of line
cor. moved stake N. to N. 3 line.
Begin at 1/4 cor. on West

Haines could place
 side of section 6" stone in
 marked a fir stump 32 S. 16
 W. 17 Ash $\frac{1}{2}$ 7.49° W. 26
 Carb. form cor. Nov. 20th 8
 through touch and fir tree
 bottom of canon steep ac.
 top of rubble steep down along
 N.E. slope.
 stream c. NW, ac.
 old stake for cor. on S.W. slope.

20.00

28.00

40.00

41.40

41.55

Survey for. Nov. 18th. 1930
Meyers. & Medley.

Run line from cor. by fence South
intersected cor. on South. 34 W. of cor. distance
15.75 at 11.81 set stake East 25 $\frac{1}{2}$ at 7.87 set stake
S. 17 at 3.94 set stake E. 08 $\frac{1}{2}$ on to cor. 15.71. etc.
Stake set on true line

Cokeran

from sec North 25.10
on C W. 40.26 end E. 4
to cor. 08 cedar stake
S. 17 tree gone marked
at 16.84 W. 16
remarked W. base. S. 100
S. 42 W. 17.83 to dam
eight cedar stake marked
sample 48 N 45 E. 66

NO

TSP RG Sec.

54
Minnie Krewson.

Description.

Beginning at a point on the Township line North 88 degrees and 45 minutes West 1380.5 feet of the quarter section corner on the North side of section 4 being also a point on West side of County Road thence following Township line North 88 degrees and 45 minutes West 211 feet to an iron pipe $1\frac{1}{2}$ in diameter and 30 inches long thence North 33 degrees and 30 minutes East 131 feet to County Road thence, following along same Southeast-erly to place of beginning.

All lying in section 21 S R 8 W. Willamette Meridian, Douglas County, Oregon and containing 30/100 of a acre.

Ernest A. Stewart

Investigation of $\frac{1}{4}$ Cor. brk
shs. 14 = 23. Sp. 27 R 3 W
old grow back standing as
described in Cor. field note.
old fir stump S. 85° W. 26 shs.
large fir cut down corner
and described in Cor. field

note books north. 77° East.
old note give in 40° N 75 E
is the distance appear
OK only difference is in
the bearing.
old corner is East 54° links
and North 4 links of true
line

	STATION	COURSE	DIST.	N.A.	S.	E.	W.
note here, north. 77° East							
old note give you 40' N 75 E							
is the old stake appears							
O.K. only difference is in							
the bearing							
old corner is East 54 links							
and North 4 links of true							
line							
				Same as C.S. 6d / S			
				(D.C. SA 2-9-94 X)			

CALCULATION No.

THE FREDERICK POST CO.
BLUE PRINTING, DRAWING MATERIAL
91 5th ST.
PORTLAND, ORE.
BRDWAY 7761

ELVIN B. SHANNON
PORTLAND, ORE.

91 FIFTH STREET, NEAR STARK
LUMBERMEN'S BLDG.

ARCHITECT • ENGINEER • ARTIST • SUPPLIES

THE POST-PENCIL COMPANY
FREDERICK COMPANY

BLUE PRINTING

PHONE BROADWAY 7761

Index

Wm. Kelly 37
 Perkins & Bebe 38
 W. G. Henderson 39-40
 Whipple & Harlan 41-42
 Benj. Watkins 43
 R. W. Jarvis 44
 J. B. Applegate 45

Index
 Aultack & Brath 1
 E. J. Jones 2, 3
 J. A. Kephart 4, 5
 J. J. Kephart 6
 E. J. Kephart 7, 8
 A. J. Kephart 9
 Leeper & Phillips 10
 Root & Root 11, 12, 13
 J. A. Fobbe 14
 E. A. Sarraon 15, 16, 17
 J. J. Miller & Phelan 18
 E. J. Douglas 19
 W. J. Cooley 20, 21
 Mary Perkins 22
 J. J. P. Craig 23-24
 J. J. Schell 25
 J. J. Miller & Co. 27, 28, 29
 J. J. Cooley 30
 Pioneer Lumber Co. 31-2
 Bent & Larnsey 33
 E. J. Stevenson 34
 O. J. Keweenaw 35
 Martin Anderson 36

1889

Oct

26

Page 7

Medley

Chenoweth 2-1

Young 325. - 1.25

" 12 1/2 25. - 1.37 1/2

" 50 300

" 2-1

" 5 Young 100. - 30. }

" 8 C. & R. R. car hire 150. }

" Chenoweth Stearns 500. (5.00)

" 250. - 100. }

" O. & R. R. 1.25

" 16 " " 1.25

" Ambrose 1.25

" L. & L. 1.25

" 18 Young 125. - 1.35. }

" 100. - 50. }

" Linnick 1.25

" Ch. H. 1.25

1889

1. 1. Hammett 1.00

5. Young 1.75

30. 50. 2.50

Oregonian

2. 15.

2. 3.00

2. 2.50

1. 1.50

1. 1.50

2. 2.50

3. 3.00

4. 4.00

5. 5.00

6. 6.00

7. 7.00

8. 8.00

9. 9.00

10. 10.00

11. 11.00

12. 12.00

13. 13.00

14. 14.00

15. 15.00

16. 16.00

17. 17.00

18. 18.00

19. 19.00

20. 20.00

1889.

5.	Young 16½ lb	22½	38.80
"	"	"	3.00
"	"	"	3.70
2	Young 26 lb	25	6.50
4	J. Tipton N.		4.00
10	M. Tipton N.		4.00
19	M. Tipton N.		6.00
15	Young 17½ lb	20	5.25
7	W. Wilson N.		4.00
30	Young 11½ lb	27½	3.15
Nov 2	Rene N.		6.00
" 4	Loiss N.		2.50
" 8	Bryant N.		2.50
" 5	Young 1½ lb	12	4.00
" 18	" 5½ lb	30	1.65