

Field Book # 117

T & R	Secs.	Page	For/Title	Date
T 0-0		1 - 3	G. Anlauf(Scots Vllly Rd)	?
0-0		9	Applegate/Bishop	?
1 0-0		22 - 24	Computations	
T 0-0		26	City of Yoncalla/Fee Chgd	?
T 0-0		57 - 58	Craig & Barker	10/3,10/43
T 0-0		59 - 61	Harold Turnpin	10/12-13/43
T 0-0		65 - 67	Lane County	
T 0-0		75 - 76	Wiley Chamberlin	6/29/42
T 0-0		77	Jim Whipple	9/3/42
T 0-0		81 - 82	Dr. Radabauch (?)	10/5/42
T 0-0		83	J. H. Booker	12/20/42
T 0-0		98	Carl Bender	7/24/43
T 0-0		100	R.C. McKay/Road Survey	8/1/43
T 0-0		101	R.C. McKay/Lane County	8/1/43
T 0-0		107 - 110	Catching & Randell Rd Surv	11/29/43
T 0-0	♥	94	Baldwin	?
T 0-0	19/30	45 - 47	L.A. Bachelder	4/11/42
T 0-0	27	32	Chancy Smith	7/10/42
T19-1		6 - 8	Ruby B. Crain/Lane Co.	?
T20-2	19	55 - 56	Wm. Perini/Lane County	9/24-25/43
T20-2	20	52 -54	S. Lindroth/Lane County	11/15-16/43
T21-4	20	74	Gray at Comstock	6/16/42
T21-4	20 ♥	104	Elva Littlepage	12/29-30/43
T21-4	33	49	Lem. M. Brown	5/23/42
T21-5	4	4 - 5	Minnie Krewson (?)	?
T21-5	16 & 17	27	Dr. Devore	6/21/42
1-5	29	30 - 31	Whipple	7/6/42
1-6	24 ♥	79	Jas. Whipple	9/16-21/42
T21-7	24,25,26♥	48	?	?
T22-3	19 ♥	51	S. Lindroth/Lane County	9/21-23/43
T22-4	24	51	S. Lindroth/Lane County	9/21-23/43
T22-4	24	88,89,93	R.C. McKay	2/28/43
T22-4	36 ♥	69	Kissling	11/17-18/41
T22-5	2	97 & 99	E.G. Whipple	7/15-21/43
T22-5	29/34/35♥	28 - 29	A.E. Thomas	6/29-7/1/42
T22-5	34/35 ¼♥	21 ♣C.S. 61/45	Corners Re-established	
T22-6	1 ♥	63 - 64	I.W. Hains	10/25/43
T22-6	15	84 - 87	Cuttingham & Hill	12/26/42
T22-6	8,9,16	11	Ada Hicks	?
T22-7	2 & 11	95 - 96	Carl Binder	4/13-24/43
T22-8	?	39 - 41	H.G. Brown & W.D. Palmer	3/17-19/42
T22-8	9	90	Palmer	?
T22-8	15	36 - 38	Agee & Brown	?
T23-4	10 ♥	105 - 106	Alvin Baldwin	11/2,6/43
T23-4	19/30 ¼ ♥	21 ♣C.S. 61/45	Corners Re-established	
T23-4	29/30 ¼ ♥	21 ♣C.S. 61/45	Corners Re-established	
T23-4	29 ♥	31	Joe Pringle	7/9/42
T23-4	30 ♥	33	Bigalow/By Pringle Bros.	8/14/42
T23-5	♥	12 - 18	Shelly Est.	3/31-4/7/42
T23-5	2	19	H. Burt	?
T24-5	5	25	W.C. Thorp	May 1942

♥ Denotes Government corners set & BTs marked or re-marked.

♣ Denotes that the survey is similar to the map number given.

C:\DATA\WP51\THIEL\14FB117.SOR

Field
Book
117

Book 14

FB 117 = OFT Book 14

B. Anlauf 1
 From fence line
 along S side of pavement
 S 36 1/2 W 265 S 12 1/2 W 174
 S 15 W 650 S 25 1/2 W 700
 S 25 W at 90 Scott Valley Rd
 280 to line 1306 E of 16 Rd

at corner 2382 E of 16 Rd
 fir brs S 86 E. offset N. 50
 top of tree here S 76 E
 about 250 or 300.

station on R.R. of W. fir
 tree brs N. 68 W N 28 E

9.00
 12.60
 1.74
 13.50
 2.86
 20.69

Baldwin

4000
 C. S. stake
 12 1/2 ft

90
 153
 47

$$\begin{array}{r} 622 \\ \times 6 \\ \hline 3732 \\ \hline \end{array}$$

$$\begin{array}{r} 66 \\ \times 33 \\ \hline 198 \\ 1980 \\ \hline 2178 \\ \hline \end{array}$$

6.50

2

$$\begin{array}{r} 6.22 \\ \times 2 \\ \hline 12.44 \\ \hline 4.15 \\ \hline \end{array}$$

from $\frac{1}{76}$ cor. N 88 $\frac{1}{2}$ W 319 ft

Cont. 30/100 acres

N. 14.25 ft	66.600	9.44	20.00
N. 10.2 ft	59.4		
stake 1250			3
East 12 ft		18	
N. 40.00 38 ft		57	57
60 60		96	
8.2 39 40 33.8		49	49
19.7062		93	58
N. 319. 10		07	
8 108	265	398	
2361	133		
	398	5.99	
18 (6) 265	401	12.50	
90 224		18.49	
93 12725	100	20.00	
398 108		2 38.49	
599	8.08	19.25	
	36		
265	44	One fence	
15.90	N. 33 $\frac{1}{2}$ E		
15.90	131 ft R of W		

100 Aug 06/60 0.91
 350 59 4
 100 66/630 195
 59 4 4
 \$1.50. 319 3 60
 108 3 36

211
 108
 316
 211
 131
 65
 196
 319.
 108
 211

218 R. SW.

Corn in center of Titch cr or
 Smith Co. A E. bdy line of
 N.E. 1/4 of N.W. 1/4 of Sec 4
 N along said boundary
 to N.E. cor. of N.W. 1/4 thence
 W along the North bdy
 of said section to center of
 Titch cr. thence to the place
 of beginning

89 60
 30
 88.30

N 33 1/2 W 83 E 55
 167 110

East 12.50 chas. 12.50

" 12 ft. 3.16
 1.67 .18

316 " 60 " 2212 91

158 " 63 " 1894 95

316 " 265 52772 401

26 18.55

2000

1928 = 1272.5 ft.

108
 1380.5 ft

2 38.55

19.28

12.72.5

108 across cord

1380.5, W side of Cord

211.

1591.5 ft thence N 33 1/2 E 131

ft. to Co. road thence S. easterly


along same to Tpline thence

N 88° 45' W along same 131 ft

Begin at a point on Tpline N.

88° 45' W 1380.5 ft. of the 4 sec

or on side of section 4

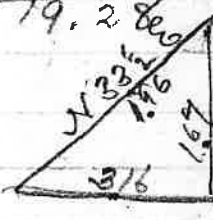

Sp. 18 SW.

6

Mr. Glen Davis
Eugene

1475 Agate St.

Guy Woods,
Lowell

Miss Clarence

Owen R. Crain

175 Hogg way.
San Gabriel
Calif

Ruby B Crain
829 W. 41st Street
Los Angeles

Ora Carter
Lowell

Ruby B. Crain

Aug 12 left home 2 Pm

" 13 1 day Sun. \$8.00

" 14 1 " " 8.00

" 15 2 " " 4.00

" " 2 idle on 3.00

account of No. help. 23.50

15 fare to Goshen
and return

1.50

23 Fare to Goshen

.80

" Ora Carter

4.00

24 " "

8.00

25 " "

7.00

" Fare to General's

.80

20.60

23.00

43.60

24	19
	N 89° 41' E 78.26
25	30

74.19871
20

29

8

30 }
 " 28 S 31° W 96 } n.e. cor
 " 36 N 35° W 146 }
 " 30 S 87° E 91 }

N 89° 45' E true line
 1426 stream 20 N.E.
 38.26

maple 15 N 46° E 86
 " 15 S 3° E 82
 69.26 at stream 25 W N.E.
 78.26 to cor.

Survey S. from 1/4 cor. 1925
 wire fence cor. is N 65° E
 followed line S to pipe cor. Run
 N. 89° 3/4 W. 42.30 to N is line 160
 N. as 1/4 cor

Geo A. Applegate
J. D. Bishop

Box at N.W. cor of Ch.
4th

N 89° 20' E 15.80

South 14.00

S 89° 30' W 15.80

22 acres.

Wm. & Bishop

N 52° 2' W to el line
167 ft.

L. W. Metcalf 10

Door $2 \times 8 \times 6' 8$
plain 3.75

$2' 8' \times 6' 8$ 4.75

Windows \$1.25

Mar. 10 15 bunches \$13.13
Shingles

Jos. Daisley Ed no 37
 Feb 22 8706 W.
 W. E. corner

An Oak 12" 8730 E 1.07
 A fir 12 " 50 " 89.
 County Survey 860 E
 4293.7 ft intersected South
 of stone 130 ft.
 Blue print 860 E 1559 ft
 - 239 ft. (CS 1926)

Ada Hicks 95 acre.

66) 42.93.7 (65.01 chms

$$\begin{array}{r} 39 \ 6 \\ \underline{33 \ 7} \\ 33 \ 6 \\ \hline 100 \end{array}$$

$$\begin{array}{r} 15.59 \\ \underline{2 \ 39} \\ 13 \ 20 \end{array}$$
 1320 ft. $\frac{1}{4}$ mi.
 66) 130 12.00

$$\begin{array}{r} 132 \\ \underline{107} \\ 23 \end{array}$$

$$\begin{array}{r} 107 \\ \underline{11} \\ 96 \end{array}$$

$$\begin{array}{r} 96 \ 2 \\ \underline{70 \ 6} \\ 25 \ 6 \end{array}$$

$$\begin{array}{r} 89 \\ \underline{66} \\ 23 \end{array}$$

$$\begin{array}{r} 23 \ 4 \\ \underline{23 \ 4} \\ 0 \end{array}$$
 65.01 = 2.00
 = 3 lks. & 1.00
 11

May 31st 1942 12
Shelly East.

Beginning at NW cor of
B and Cl, N 87 1/2 E to
NW cor of Cowan

Went to NW cor
East 4026.5 to fence
South 775.4 ft to cor
6.15 W S. 888

East 1504.5 to fence
South 721 center cord

S 58 W 482	482	3 482
	<u>66</u>	<u>160</u>
S 36 1/2 W 7.22	2892	
S 55 1/4 W 574	<u>2892</u>	<u>(321)</u>
	31812	
3 722		
<u>241</u>		
(482)	3 374	
	<u>124</u>	
	248	

S 52 1/2 W 167 ft to line
5
172

Apr. 2nd 1942
East from NW cor 383
ft (580) to cor
marked wh. oak 24 inches
N. 63 W. 135 ft

1894. 2 from SW to NW cor.
383
952.4 40.18 N. S
3229.6 cor of 2

1894
383 ft.
2277.8 2.8 cor of One

2668.8 S from N line

Sept. 3rd 1942 14

Begin at cor S 447 ft
to center of Co road

Begin at stake on 383 E of new
cor. of Cowan den East 527

S 44 E 615 & 68 E 3.22

N 79 or 78'2 E 1500 N 53 E

110 to line (Kingery) N. 226

East 308 to stake on S side of
road thence S 208 W 270

to stake on Kingery line

Run line N. S 1010 ft to
center of Co road returned to
stake N. 1318 ft to S. line of King
land road to her cor

Apr 7th 42

Begin in center of Co. rd.
on N. S. line

N. 68 E 268.5 ft (Kintz line
(old 189) N of point on former
survey - 3.72 to stake N 54 E

N 53 E 163 to stake

N. 68 E 268 ft

" 54 " 376

" 53 " 163

Begin at Kintz line
S. E. cor W. 701 ft

66) 701 (10.62

66

410

396

140

2148

588

2736

15

$$\begin{array}{r}
 35.37 \\
 27.36 \\
 \hline
 63.23 \\
 31.61 \\
 \hline
 31.61
 \end{array}
 \qquad
 \begin{array}{r}
 31.61 \\
 10.62 \\
 \hline
 63.22 \\
 189.66 \\
 \hline
 31.61
 \end{array}
 \qquad
 16$$

$$\begin{array}{r}
 33.56982 \\
 1.60 \\
 \hline
 31.9698
 \end{array}$$

$$\begin{array}{r}
 17.87 \\
 \hline
 49.9398
 \end{array}$$

$$\begin{array}{r}
 11.23 \\
 66 \\
 \hline
 6738 \\
 6738 \\
 \hline
 741.18 W
 \end{array}
 \qquad
 \begin{array}{r}
 66 \overline{) 818} \quad (12.40 \\
 66 \\
 \hline
 158 \\
 132 \\
 \hline
 260
 \end{array}$$

$$\begin{array}{r}
 2280 \\
 1057 \\
 \hline
 12.23
 \end{array}
 \qquad
 \begin{array}{r}
 1223 \\
 66 \\
 \hline
 237338 \\
 1338 \\
 \hline
 807.18
 \end{array}
 \qquad
 \begin{array}{r}
 1057 \\
 1223 \\
 \hline
 2280
 \end{array}$$

$$\begin{array}{r}
 147 \\
 132 \\
 \hline
 152 \\
 132 \\
 \hline
 290
 \end{array}$$

1596.5
Cart mark

F.T.	818	17
807.2	<u>775.4</u>	
788.5	1593.4	
<u>1595.7</u>		

Harris & Byson
 Miner Bldg.
 City & Land

Smith	14.00
C.F.A.	14.00

1223	1174
<u>1240</u>	<u>1240</u>
48920	24.14
24.46	<u>12.</u>
<u>1223</u>	4828
1516.520	<u>24.14</u>
	289.68

1976 South & 82nd Cor on hill

1076

818

975.4

635-

49

1,35

480

18

2669.4 81

985.4

Net 952.4

33

66/952.4

66

292

264

280

264

160

March across river up
Cl. 2719 plus 2719 (41,20)

264

79

66
130

H Bush

60.89 N 89½ E and

29.49 S of NW cor. of

L. Applegate, S 29.57

S bdy of cl. E 22.75

N 29.57 S 89½ W 22.75

67.15 area

29.49

29.57

59.00

South East 60.89

20

25
Corners re-established
Bigelow Survey
Tp. 23 S R. 4 W
1/4 cor. bet crs 19 & 30
Set a cedar post
marked a fir 20 N 84 W
42. 2 feet 16 N 56 W 60
Don Bigelow Marion Bigo
1/4 cor bet 29 & 30
Cedar post. Tp. 23 S R. 4
fir 24 N 26 W 7 W.
cedar 10 S 52 E 24
stump of Saw tree found
Bigelow
Don.

1/4 cor bet 34 & 35
Tp. 22 S R. 5 W
wh oak 8 S 30 W 17 ft
bl " 12 N 10 E 17 ft
Chas. Smith ark Thomas.

Mc Coy
 Neil by Pringle
 May 18th 1942
 " 19th " 22

$$\begin{array}{r}
 18^{\circ} = 5280 \\
 10 = 528 = 1 \text{ mile} \\
 10 = 53 \quad 371 \\
 \hline
 140 \\
 66 \\
 \hline
 840 \\
 840 \\
 \hline
 92.40
 \end{array}$$

$$\begin{array}{r}
 7) 528 \quad 17 \quad 53 \\
 \underline{49} \quad \quad \quad \underline{7} \\
 38 \quad \quad \quad 371 \\
 \hline
 140 \\
 66 \\
 \hline
 840 \\
 840 \\
 \hline
 92.40
 \end{array}$$

$$\begin{array}{r}
 92.4) 3710 \quad 4 \quad 92.4 \\
 \underline{4 \quad 3696} \\
 3696 \quad 140 \\
 \hline
 92) 371 \quad 4^{\circ}
 \end{array}$$

$$\begin{array}{r}
 10 = 1'' = 92) 371 \quad 4^{\circ} \\
 10 = 53 \\
 7^{\circ} = 371
 \end{array}$$

$$10^\circ = 528 \text{ ft. per mi}$$

$$1^\circ = 52.8 \text{ "}$$

$$1^\circ = \text{on mi} = 92.4 \text{ ft}$$

$$92.4 \overline{) 5280 \text{ ft.}} \quad (57)$$

$$\underline{4520}$$

$$660$$

1175
149
 13.24

24

S 11 1/2 W	Chino	225	149
" 43 E		190	126
" 54 1/2 "		2.13	142
" 46 "		343	229
" 11 "		195	130
" 18 W		135	89 7 46
" 41 "		181	154
" 83 "		200	134
" 52 "		1.61	107 919
" 14 "		2.13	142
" 7 "		2.94	196 N.S. line
" - "		1.42	95 cot.

1693 1693

59

63

May 14th pre 5.30 24824^W
W.C. Thorp
May 20th 1942 25

~~200~~
~~51~~ South 149 ft.
149

Begin 50 ft E of 1/4 cor
S 112° W 149 ft S 43° E
126° S 54° E 142° E
S 46° E 2.29 S 118° E 130°
S 18° W 89 S 41° W 154°
S 83° W 134 S 52° W 107°
S 14° W 142 S 7° W 196°
on n + S line 95 to 100 cor
est by former survey

May 15th 18, 19 & 20th
June 13th line S. E. n
4 29 5 85 7 hrs.

City of Yoncalla
June 1st 1942 26

Uncovering pipe
and ~~at~~ Howes.
~~1/2 hour~~
" digging by McEarn-
ing 1 1/2 hrs.

4/10 E. B. Whipple
ck for \$32.00
" " 8.00

27

Surrey Dr. DeVore
June 21st 1942

Begin at NW cor of
R.R. 21 Tp. 21 S R. 5 W
S.E. 1/4 bearing trees
standing North from cor.
Var. 20° to E. Set mark
chain line

At 1/4 cor. old post in place
fir tree East and large
fir S.W. with marks.

Run line East along S
slope change to East slope
down to creek and road

W. G. Thomas

28

June 29, 30 7-1

Begin at N.W. cor of sec
35 Tp. 22 S R. 5 N. all trees
gone the cedar N 5 W. 30.
South

asc. 16.00 top ridge c E. N
20.00 limp cut on old blazed
line 40.09 Ent E of cor 7 ft

2003 fir post.

marked a fir

40 South 42 lbs

28 N. 60 E. 26 lbs

East.

21.50 top of ridge trail

40.00 dogwood N of stream

marked fir 27 N. 32° W 41 ft

" 60 S 48° W 49 ft.

(47) stone 14 x 10
x 7 wh oak 12 5
30 W. 17 ft
black 12 N 10 E 17 1/2 ft

North.

steep asc 1200 top E. w.
steep desc. 2008 to 1/4 cor. E. w.
cor. 10. 1/4 cor. fir post.

S.E. tree gone N.W. standing
marked fir 12 N 87 E 12 ft.
" " 10 N 63 W 12 "

East from cor 1500 by
a spur 2000 wh fir post.

In top of dividing ridge
marked fir 14 N 70 E 12 1/2 ft
" 36 S 68 W 20 "

South along W. slope
1500 top ridge E. N. E. S. w.

2000 maple post marked
maple 8 N 10 W 17 ft

fir 10 S 33 W 12 " on E. slope

Blazed line W. to cabin

Whipple 8-6 42
33
30 12
21

Begin SE cor NE $\frac{1}{4}$
of SW $\frac{1}{4}$ sec 29. 165
Tp 21 S R. 5 W 132
122

Begin 7.25 N. of $\frac{1}{4}$ cor
center of road there.

N 47 $\frac{1}{2}$ ° W 144 $\frac{1}{2}$ ft N 65° W 450

N. 50° W 5.10 N 39° W 2.00

N. 55° W 5.10 to E. W line
West 1.42 to stake.

6.35
4.90
1.45

~~6.00~~

House Tp. 21 S R 5 W.


31

NE 1/4

NE 1/4

SW 1/4

SE 1/4

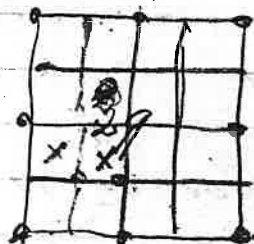

8am to 6pm

Poirnglo (Joe)

NE 1/4 SE 1/4 Sec 29
Tp 23 S R 4 W. East
18.6 of NE Tp 23 S R 4

July 9th 42

Begin at the S.W. cor of SW 1/4
of NW 1/4 Sec 29 Tp 23 S R 4 W. East
For west 23 1/2 1940 or 5 c 8 & 2010
cedar post marked cedar 580 W
cedar 12 866 E 22 ft 8 1/2 ft

South 50 stream SE
July 31st and Aug 1st 2 days

Chancy Smith 32

7-10-42

Begin at S.E. cor. of sec
27. North. asc.

38.50 top of divide ridge

40.10 stone 12 x 8 x 5

marked for 15 S 10° E 25 1/2 ft.

Cor. on N. slope.

West from cor. asc 2.50

top of divide c N.W. S.E. steep

desc. 11.00 btm of gulch c

S.W. 18.00 top of ridge S.W.

32 stream c S.W. 12.50 stake

July 12-42

Begin S.E. cor. of Mrs. Woods.

both trees standing (rock)

North 5.00 top steep desc 15.40

Stream N. 20.18 for post

for 12 N 57° E 3 ft. for 18 S 53° W 9 1/2 ft

East. 7.60 Int. N. of stake 60 ft

S.E. cor 4 27 m. to bench Int. S.

Bigalaw by 33
Dringie Props.
Aug 14th 42

Begin at stake set by
former survey on N. side
of sec. 30 Tp. 23rd R. 4 W.

Set this corner marked
a wh. fir 8 N. E. 10 feet,
a dogwood 5 S. E. 8 "

South line 2012 set stake
marked wh. fir 14 S. E. 66 ft

" " " 8 N. E. 7 1/2 "

Steel clay iron chain this
line set. North of cor. 66
ft. Var of line various
Moral at stake N. 66 ft

Robt. Campbell
Mar. 24-25 1941,
(June 25th \$5.00)

34

Mar. 24 th	4 hrs.	\$3.50
" 25 th	7 "	\$6.30
		9.80
June 25		\$5.00
		Total \$14.80

Ip 25 & P 5 W
Not Paid

Mar. 8th 1943

Gov. corners sent to C.S.

Cur. to res. 21, 22, 27, 28
Tp. 21 & R. 5 N.

Cur. to res. 1, 2, 11 & 12
Tp. 23 & R. 4 N.

Cur. to res. 2, 3, 10 & 11
Tp. 24 & R. 4 N.

4 cur. bet. res. 34 & 35
Tp. 22 & R. 5 N.

Agile & Brown

36


20. x 11.81

South 55.70 ft.

1000 ft.	<u>6.95</u>	11.81	<u>55.70</u>
2310	48.75	66	<u>15.15</u>
	<u>66</u>	7086	<u>40.55</u>
3310	292.50	2086	
3217.5	292.50	779.46	
935	321	750	


1000	15.15	4217.5	55.70
<u>66</u>			<u>15.15</u>
340			40.55
330		48.75	
<u>100</u>		<u>66</u>	
66		292.50	
340		292.50	
		3217.50	
		24330	
		<u>24330</u>	
		2676.30	

3217.50	3217.50	48.75
66	1000	15.15
3202.35	22.17.50	<u>33.60</u>

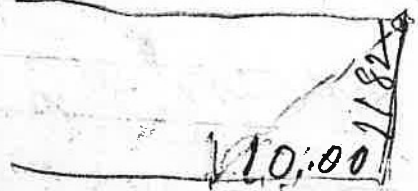

330	3960	112
<u>330</u>		
660		

Agel & Borocor
 Tp. 22 S R 8 W.
 From NE cor of 15
 N. 1320 ft South 1000 ft
 N. 1320 North to Cl. line 462
 South 3217.5 ft to Cl. line

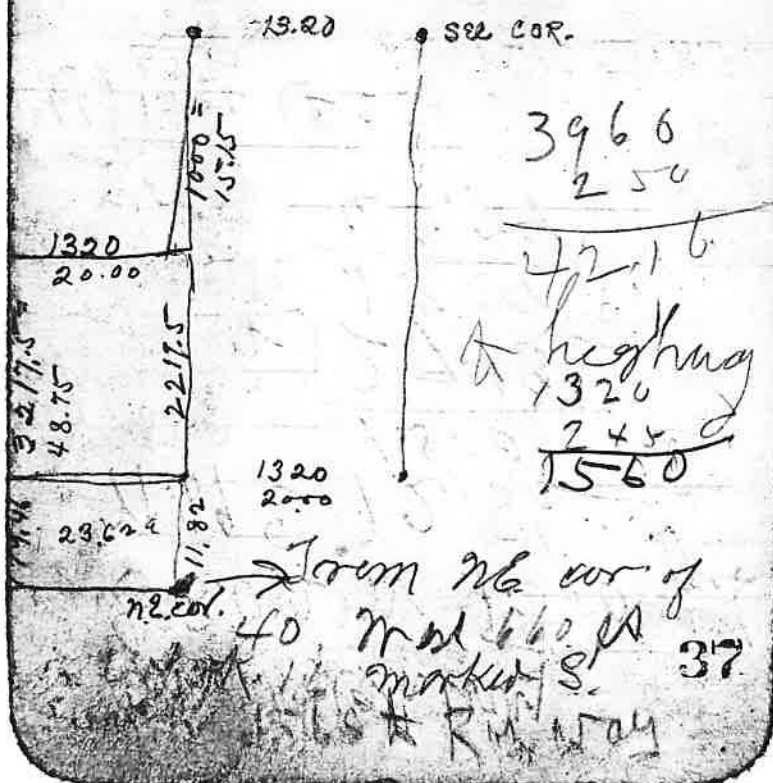

OK. Flying

38

8802W 1500 ft

1189 E 12182
1500

2) 27182

1359

40.77



66) 1500 (22.74

132

180

132

480

462

280

220

66) 1218.5 (18.46

558

528

305

264

411

396

1180 1/2 E 22.74 = 22.16

1189 1/2 E 18.46 18.45

1180 1/2 E 20.00 = 19.70 40.61

200 197

30 197

22.87

H. G. 39 N. G. 722 SRM

Brown & Palmer

Mar. 17, 18-19 1943.

Begin at a stone cor.
(6' 10" x 16") or 36 ft. East
of trail corner a maple
20" S 3° W. 6 ft. This stone
was set by Cole. From
the stone turn east of Cal.
line. 50 center of Highway
course N. 5° E. 2075 stop at
6.00 set stake for corner
6.50 old trail N. 5 10.50 stake
26.00 stake marked a
double dogwood 10 m. E. 25'
South from corner followed
old blazed line S. & W.
through heavy brush 6.50 stake
for S. E. cor of Lat.

Begin at S. E. corner of sec 9
3 ft. hazel post from NW and
SW trees NW dead

40

Brown & Palmer.

Run North from S.E. cor of
9 about 1500 intersected
E of line 7 or 8 rods, follow-
ed old blazed line)

Returned to S.E. cor of 9
and run line West to High-
way set post and marked.
first 10" bears East .06 marked
S.B.T.

At 1050 East of stone witness
cor. Cl. No 50 Run North 5.75
to center of Paradise Cr. course
of Cr. N to N. 8.00 or 9.00 thence
North westerly center of Cr over
Highway bridge N. 5° W and west
to meander line on East bank of
River. From a point 100 East of
stone cor. East side bridge
line N. 5° E 1300. From E side of
bridge to E bank 275 (River)

42

43

Radabough 4-11

43

$$\begin{array}{r} 23.00 \quad 10000 \\ \underline{9200} \quad 4.34 \\ 8000 \\ \underline{6900} \\ 1000 \end{array}$$

$$\begin{array}{r} 23.10 \\ \underline{4.34} \\ 9240 \\ \underline{6930} \\ 9240 \\ \underline{10825.40} \\ 1.80 \\ \underline{822} \end{array}$$

$$\begin{array}{r} 10.25 \\ 5.12 \end{array}$$

$$\begin{array}{r} 346.5 \\ \underline{23.10} \\ 365 \end{array}$$

for tree

$$\begin{array}{r} 1546 \\ \underline{3160} \\ 82 \\ \underline{1988} \\ 2110 \end{array}$$

Roadway 33k urdu
Thompa
8856 390k
468 "

2000 N. W. of General
 date 17. 18.
 11 85 N. 5.91 S. 10.00
 General

$$\begin{array}{r} 300 \\ 27 \\ \hline 473 \end{array}$$

$$\begin{array}{r} 600 \\ 9 \\ \hline 501 \end{array}$$
 Rodney Cheng
 7154 1/2 W. 473 Street

4-11-43, 11.11

38

19

52

L. a. Bachelder

Begin on line fence
cor. ~~Here~~ 19.30 ~~West~~
line fence N. Var 21'40 E
West to River 44 yds. to
1251 to center of River

N. 20° W 11.64 chains

N 200 center of River

N 20° W. 3.25 (1489)

N to center of River 1.25

N 19° E 5.50 100 NW
to center of River

N 39° E 18.50 E of bridge

N 42° E 192 to E line
to center of River 75

2010

200

1810

46

66 99
28 15

94 114

90,40

110
260,4

300 100

45

255

58

233' W 7960
7200 stream

13.50
6.50
10.00

wire fence
south
125

Begin at S.E. cor of 19
N along wire fence 2010.
ft. to fir tree on bank of
River. North from cor
1300 ft. E-W fence on hill
East.

From fir tree of Bank S
200.04 ft
N 53 W. 255 ft to R of W.
Highway
Across bridge 142 ft

S 71 W. 94 ft
N 53 " 114

Bachelor

see 16
N 8 W
Lot 1
15.38 acre
47

2p. 218R 7W
4 cor bet 24 & 25

48

S 89° 39' W

27.50 cr. 5-08.

3980

for 20 N 80 E 20
" 18 S 14 W 32

~~N bet 35-36~~

~~15.00 stream bed~~

N bet 25-26

80.00 for 24 in for car post

for 50 N 45 E 65

" 8 S 50 W 97

" 14 N 40 " 22

" 10 S 16 E 47

Lem. M Brown
May 23rd 1948

Begin at NW cor of
sec 33 Tp. 21 S R 4 W
drive a cedar stake in
hole of old stake set by
C.S.

Run East along wire
fence 20.08 set of cedar
post on N. side of wire
fence.

Run South from cor.
to Co. road 21° 40'

Run line from ^{cor} 76, set on
40 acre line N of 4 sec cor
between secs 32 & 33 Gang
line North from cor to Co
Road. No chaining 49

50

Sept 21, 22, 23 '42
L Lindroth

Tp. 22 S R 3.4 W.
Begin at the 4 sec cor
on West side of sec 19
set a sandstone 18x16x8
from the SW tree other
gone Run S 89° E 42.85 —
| At the 4 cor marked
a cedar 5 S 16½° E 9 ft.
a fir 40 N 28 W 18"
— set a new post Run
North Var 20° 30' did not
chain this line. Went to S.E.
cor. of McKay land run S 89½°
E 20.00 set new post from
this cor. run S 89½° E to intersect
ion of N-S line set a new
post on South side of road.

S. Lindroth

52

Tp 20 S R 2 W.

Sec. 20 (Nov. 15-16-43)

Begin at a fence cor. 20 10

West of NE cor. sec. 28.

Run East acc. sec. cor.
stands on E. slope, all old
trees standing. Sw. NW dead
South 91-16-43

followed old blazed line

2.000 cedar stake 29.90

Stream E. 40° no trace
of old cor. a fir 40 with
old cut as might be a
NE or NW bearing tree.

West from corner
acc. 780 top at this point
on top of ridge the
needle was much dis-
turbed. No. of 0 off.

S. Lindroth

Begin at S.W. cor of Mc
Koy survey (Var. 20 $\frac{1}{2}$) Run
West 12.00 top of ridge
along on steep S. slope
to cor. eq. cedar post &
marked

fir 16" δ 30 W 10 ft.

eq. 3" δ 43 E 7" 8 in.

South from cor/Var. 20 $\frac{1}{2}$
490 stream & E.

20.10 set a fir post.

marked fir 16" δ 32 E 23 $\frac{1}{2}$ ft.

" " 10" δ 78 W 30 "

Var. 21° Run δ 2° W = 20 $\frac{1}{2}$ °

Linderooth acct.

54

Sept. 21 Surveying
 Begin @ 8 to 5-30 11.25
 Hotel room 1.75
 supper 9 hrs 4.00
13.50

22. Surveying 11.25
 9 1/2 hrs. 11.88
 Supper 60
 Room 1.75
 Break. L. 65
14.88

23 Surveying
 8 hrs. 10.00
 Break. Lunch 70
10.70

\$13.50
 14.88
 10.70
39.08

22 cash. 16.00
29.08

1943 55

Wm Perini

Sept 24th & 25

If 20 & R. 2 W.

Begin at the S & E.

Cor. of sec. 19. iron post,
on S. side of road. Run
North along old wire fence
Var. 21°. seemed to follow
old line fence on old blaz-
ed line at 20.00 turn 10°
Cor. 4. to 4 cor. post
set by C.S. Begin at the
4 cor. North on old blazed
line 20.00. Marked for "E"
for cor post.

West from cor. desc.
20.00 yellow post 20.00 3 & E 4 ft
South 125 cream c. New
20.00 yellow post 4000. Cedar
Jawed N of top for 50 N E 3 ft.
Bad. Ent. S of cor. 11

1943

Wm. Perini 56

24th. Surveying \$ 10.00
" 3 + 5 hrs
" Hotel room 1.25
" Groc. 40

25th 10.00
breakfast .75

22.40

24th. \$ 11.65
25 10.75
Paid \$ 22.40
Oct 25th. Ch 22.40

6	10.00
5	10.00
2	20.00

H.A.P. Logging Co
Wm. Perini - From Abene

Orin 3rd & 10th 1943

Corang & Bartel

From cor (2) $\frac{4}{2}$ 78 ft
from cor (4) 8. 85 $\frac{1}{2}$ ft. 57
 $66 + 12 + 7\frac{1}{2}$ 78
 $\frac{7}{85}$ ft.

20° 40.07 from bulk head 13 ft
eg. 22 $\frac{1}{2}$ ft S of true cor
East from 630 on S line

E & W line S 89° W

S 1° W 6.45 from peg
from iron peg S 62° W
41 ft. S 80° E to highway
S W. on W side 49 ft.

2	85		
	42	33	
	25	92	
	27	42	

E 3.67 Craig
 S 2 1/2 W 3.80 Barker

" 2 E 5.70

East 2.70



58

η 6 E 9.35 to place of log

E from to cor 6.50 to N. 8
 325
 297
 6.22

S 645 E 2.97
 S 63/4 W 4.43
 E 3.41

20.03 40.07

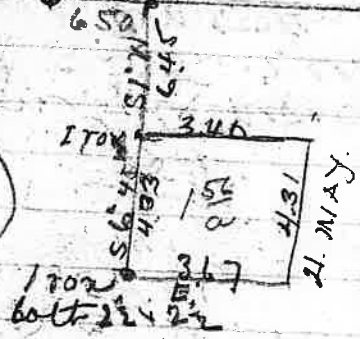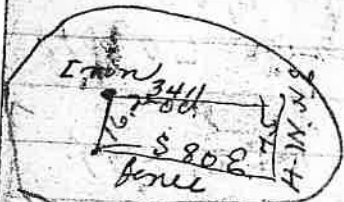

23.30
 22.00
 2 45.30
 22.65

850
 3.36
 2 11.86
 5.98

22.65
 3.93
 62.95
 19.38
 11.325

45 a cres

475 1050 1680
130 1030

Harold Turpin

Oct. 12th 1948

" 13th

59

475 Begin on N. side

130

1050

1.635

g road for post

N. 53° W. 3.36

" 32 283 13.95

" " 2000

S. 62° E 781 to N

side of H.W. fence + 24th

along road S. 39° 44'

021.10 164 N to stake

Pole line N 39° E

780

340

21120

560

2000

580

1200

1000

1250

96

28

62

all iron pipe
gal. $1\frac{1}{4} \times 18$ for ch.

60

Nest on spline

$73\frac{1}{2}$ ft ^{1.11 chs} veg. point
15.39 East of bearing tree
1500 + 26 ft

old bearing $N. 80^{\circ} W = 79$

bl. walnut tree S55E 375
24 in diam

Stake marked 1500

8 + W line is $N. 67^{\circ} W$

S62E 8.47 to fence

on iron bar $3\frac{1}{2}$ ft

distg. marked cherry

tree 12 $N. 62^{\circ} W 10\frac{1}{2}$ ft

2.24 S. 39 W. along
N. side of H. W. to previous
line.

bearing tree for 2p cr

hrs N 80 W 67 $\frac{16.53}{01.11}$
15.00
 $\frac{1.53}{13.49}$
15.42

Point of beginning is
73.2 ft = (1.11 chs) of the N 28 E cor
of sec. 1. stake No 6. 15.00
S. 28.2 E 1.01 chs (67 ft)

N. or S. 28.2 E 13.99 chs to
the sec. or 2p line and W. by
N. E. cor of sec 1 1.11 chs.

113.40
acres

62

Beginning at a point 11.04 chains west and 9.42 chains south of the interior corner of Samuel Turners Donation Land Claim No. 50 in township 22 S R 8 West of Willamette Meridian which is a post on the west side of the County road, leading from Elkton to Scottsburg, from which a double fir 20 inches in diameter bears N 17° E 26 links distant and marked S B T, running thence S 23° W 3.94 chains, thence N 47° W 3.17 chains thence N 23° E 3.94 chains, thence S 47° E 3.17 chains to the place of beginning all lying in section nine township 22 S R 8 west in Douglas County, Oregon, and containing one acre.

1909

Craig
 Begin 26.53 N.
 89° E of 1/2 sec
 cor. on W side of
 sec. 4 Tp. 22 S R 8
 W. and 6.45 chs S 10°
 W. at an iron stake
~~thence S 80° E~~ thence East
 34.1 chs to Highway
 right of way thence
 thence southwesterly
 along highway 7.5
 links thence north
 westerly to a point 16
 chs S 70° W of the beg-
 ining point thence
 N 10° E 16 links to place
 of beginning all in the
 NE 1/4 of NW 1/4 of sec 4
 Tp. 22 S R 8 W. 15/100 acre

W.D. Palmer
Paradise

S.W. cor of Q. 50
6x10x16 36 ft E
2 cor. marked maple
14 S 30°W 6 ft.
12 added N 89°E 25 ft.

Interior cor
cedar post 4x5 in
fir 14 S 80°E W 49 etc
" 16 N 67°W 40
(1908)

1/4 cor. bet 9-10
fir 8 S 83°E 22
" 8 N 45°W 20
N. 200 road

N on truck line 9-16
28.00 cor road on River
fir stump 24 for cor 9-16
fir 6 N 50°E 71
" 6 S 41°W 139
~~N bet 9-10 road 21~~
~~200 by of open~~
~~2000 on 4 road E~~
N. bet 9-10
35 or 50 C NW
N.E. cor 16
7850
fir 30 S 84°E 41
Oak 15 S 83°W 61

J. W. Hains
Oct. 25th 1948.

Begin at N.E. cor of sec.
1. Tp. 22 S. R. 6 W. Var 21°
buried a stone 8x14x14 in
road & gate. S.E. SW trees
standing. Run S 89° 15' W.
9.25 intersect south of iron
rod by wh oak tree. 10 links
continued W. to Co. Road
5.00 set fir stake thence S.
26' E. along E. side of Co road
3.47 to post N. 89° 18' E. 5.00
to a post thence N. 26' W. 3.47
to iron pin. Cont.

Begin at N.E. cor of 1 S. 3.47
sailed post. marked
a wh oak 18 S 44' W. 41
S 89° 15' W. 9.28 to post.
Cont. 3.22 acres

W W Hains

64

Begin at the SE cor
of School lot. Set up
S 00.15' E 1900 West 280
S. 310 to wire fence

Begin at stone cor on E
end of fence and measured
N 89° W 13.22 to West side
of Co road.

N 9° E 2.00 N 89° W
5.20 for peg. S 9° W 2.00
S 89° E 5.00 to post on W
side of Co road.

Intersect 1. Corn 1 acre

$$\begin{array}{r} 9.25 \times 3.47 \\ 3.47 \\ \hline 64.45 \\ 3700 \\ 2775 \\ \hline 3209.75 \end{array}$$

$$\begin{array}{r} 3.47 \\ 5. \\ \hline 17.35 \\ 13.20 \\ 891. \\ \hline 22.11 \end{array}$$

$$\begin{array}{r} 1994 \\ 579 \\ \hline 25.73 \end{array}$$

maple 12 N. 48 W. 12

65

Ip. 19 S R 7 W

5.55 lbs.

S. 89° 37' W. 80.70;

bst area 24-25

N.E. cor. 4 sec. 24

138

fir 40 N. 77° E. 18 lbs

" 24 S. 3° E. 2.52.

" 18 S. 2° W. 97

Var. 19° 20' E

South

5.00 spring E. 15

40.00 1/4 cor

fir 24

Laurel 10

500 = 750

47-9

R 10. 6-44

4 cor bst 24-25

two fir trees.

S. 2

7/30 Fare to Cres	66.68
7/31 Hotel	1.00
7/30 Surv	7.50
7/31 "	7.50
8/1 Hotel	1.00
" Fare to Genetta	65
" Surv	7.50
	25.80

A. C. Denney
Harry Holt
Shirley Pennington

3- 22.50
3.30

25.80

Send 2nd statement Aug 14th

Tp. 19 S R 3 W. 67

South on N. boundary of sec
19, T. 19 S R 3 W. var. $19^{\circ} 20' E$
N. W. cor of sec 19

fir 36 N. 75 E. 186h

" 18 N. 55 W. 150

" 18 S 77 W. 97

" 24 S 3 E. 252

South.

500 small spring 15 E of line.

40.00 fir 40 S 73 W. 65

" 15 S 73 E. 15

80.00 fir 12 N. 17 E. 160 gone

" 12 S 49 E 77 "

" 30 N. 4 W. 165 "

" 40 S. 24 W. 93 O.K.

S $89^{\circ} 37' N$ but 24 + 25-

600 top of ridge

2560 ravine

4005 to cor

White oak 10 N. 41 E. 45

Larrell 8 S 30 E. 61.

Ada Sherman

450
1

Redport

Sept. 15th 42

Dec. 15th 42 SR. 4W.

69

1761
32 m 48


11/18 Nov. 17th 4th Reading
 44 m. 17 m 48. 36.
 84. 228 4 m
 Cedar road fm to 11 49 m
 12 or 18 m
 South
 along on road 20.10
 Boulevarde. all along line
 2 from cor. Newday bridge
 Lin & Co. road
 72.6 68 22.3
 45 27 2.6
 45 27 2.6
 40.8 40.8
 40.8 40.8
 40.8 40.8
 40.8 40.8

70



no 24 Lot No - 660
 30 M Rd.

~~660~~
~~330~~
~~19800~~
~~19800~~
 217800

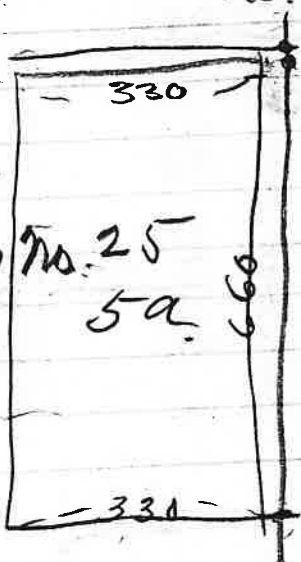

660
 660
 2010

8 Lots E c W 330 ft
 4 c N a S 660


660
 330
 19800
 19800
 217800

10. 45/100 22 3
 87

43560
 217800

Bern
 Hedrick

71

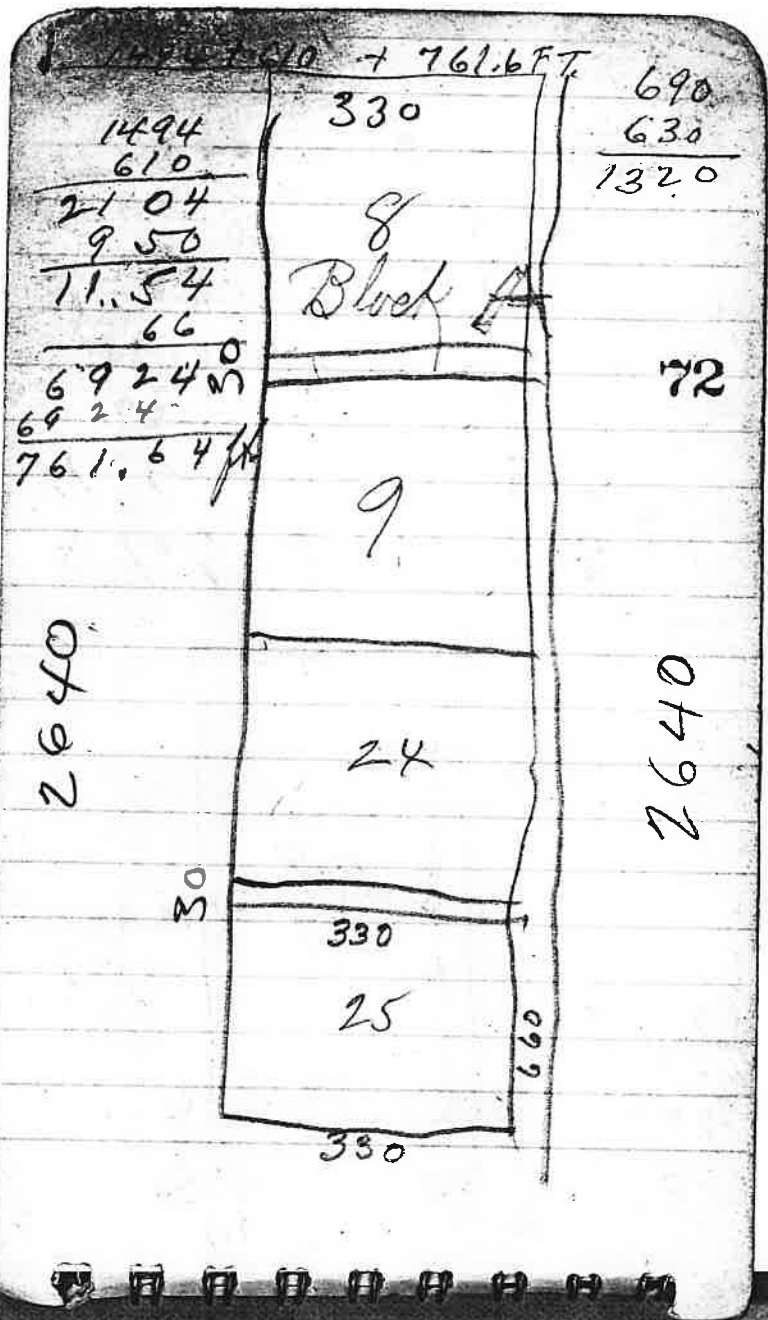

$$\begin{array}{r}
 2.85 \\
 \underline{.5} \\
 2 \overline{) 1.425} \\
 \underline{.70}
 \end{array}$$

5.00

2.85-

Survey at Cornstock

June 16th 1942

Begin at cor set by form
in Survey 1350 N 89° 3/4 W
of sec 16. 17 20. 21 Th 218 R
14 W S. 70 1/2 W 365 chm.

N. 285 to R. of W. R. R.

Next form peg 4.17. R of W
of R. R. N. 56° E R. R. right of way
7 ft from edge of ties 6.86 ft

(6.86 = 10.40) 10.40 East 4.17. to
peg N. 70 1/2 E 3.65 to line corner
N. 379 to R. R. of W.

250
150
400

J. M. Gray
Canyonville

74

11

6-29-42
 Wiley Chamberlin
 Begin on road, then
 15 ft to south side S 52° W
 116 ft. S 41½° W 23½ S
 40½ W. 384.5 S 33° W 167
 S 62 E 30 ft right-of-way
 32 ft cedar 12 S 62 E 2 ft
 101 ft to center of creek
 From Lema sign to center of
 creek from Right-of-way 120
 from 116 ft stake S 2 to center
 of cr. 130
 On north to N line 120 ft
 from R. of W. to center of cr

	470 acres	
466	<u>293</u>	75
233	177	
699		

76

25

2000

20.00

1/4000

6

852°W 116

84 1/2 W 231.5

11 40 $\frac{1}{2}$ " 384.5

11 33 " 167

899.0

Jim Whipple 77
Sept 3rd 42

Began on W line of
Good Land 10.90 chm South
of NW. cor. of SE 40th of NW 1/4
of NW. cor. of SE 40th of NW 1/4
FT.

✓ 242 + 8856 292

✓ 147 " 572 147

389 +

✓ 215 8318 215

604 +

✓ 88 88428 88

692 +

✓ 264 7578 264

956 +

284 76826284

1240

256 88226256

78

292	147	215
<u>146</u>	<u>73</u>	<u>107</u>
438	220	322

88	264	284	256
<u>44</u>	<u>132</u>	<u>142</u>	<u>128</u>
132	396	426	384

William Perini
~~Clinton~~ Oregon
 August

Tp 20 & R 2 W
 in Section 20

ck 9-14-42

Aug 25, 26, 27 3 days
 \$26.00 Paid 9/17/42

79

Jos. Whipple 1942
Sept. 16, 17, 18 & 19, 21st

Sec. 24 T. 218 R. 6 W.
5 days @ 10⁰⁰ \$50.00

S.W. cor. a cedar 18" N.W.

North brushy steep
asc. of mountain 2.00 top of
ridge E. W. 40.00 no trace of
old cor. stream N.E. steep
asc. of mountain (divide)

desc. to cor. (old stake on ground)
NW tree fir 48" fir 30" N.E.
East from cor. 5.50 top of di-
vide steep desc. 20.00 top of
ridge

CK No 5368

10-6-42 \$61.00

Paid

80

81
St. Radatouch 10-5-42

chug tree in oval

N.E. along fence 6.58
to E side of old road

S. 52° W 9.01 to iron
peg N. 13° W.

From SW cor on hill
E. along fence 9.80 to

E side of old highway
13.50 to W side P.H.

along P.H. 23.15 to
wind fence S 63¼° W

10.24 to iron peg

From New car at
 Super 1.75 to car
 24 - on W side of road
 and on Cl. line

7.27 W. 15.30 to car

1350

980

370

100

4.70

Shg \$11.00

S. W. P.

2250
100

2358

2350

Dec 20th 42 23.68

J. Q. Booker 23.78

From NW. cor of C 37

S. 1870 No corner

2378 S side of Ry W & High
way N 72 W along S. side

N 68 W 380 N 74 W 500

S. on Arline from High
way to Cr. 325 to Cr.

On West side

Begin on N side of Pass Cr

N 18 W 900 to Highway

4.60 across mts & back

Description to

H. W. Lombard

John C. Booker

Leona

Chg 7800

S. Dyer.

83

G. Cunningham

84

Feb. 26th 1942.

Begin on S. side of road
• Redspot Highway
West of center line of sec 15
Tp 22 S R. 6 W. T. 8.
N. 1622 ft N. 356 ft

$$\begin{array}{r} 2766.00 \\ 2766.00 \end{array}$$

$$\begin{array}{r} 1600 \\ 1076 \\ 520 \\ 280 \\ 840 \\ 770 \\ 750 \\ 922 \end{array}$$

$$\begin{array}{r} 16\frac{1}{2} \\ 22 \\ 32 \\ 32.1 \\ 354 \\ 167 \end{array}$$

11 11 11 11 11 11 11 11

1622 Elmer L
1040 Hill
582

1622 line from to
high point

580 to wire fence
1485 to R of way

Lab 153 to cor

S. 86 ft. out 12 ft

50 ft N.E. to

162 585
 10 40 580
 582 9 05

86

Hill

400 ft
 602

5802 1356
 290 178
 8.70 5.34

534
 870

57380
 4372

49,4580


1040
 905

2 1945

9.72 4860

2916

3460.32

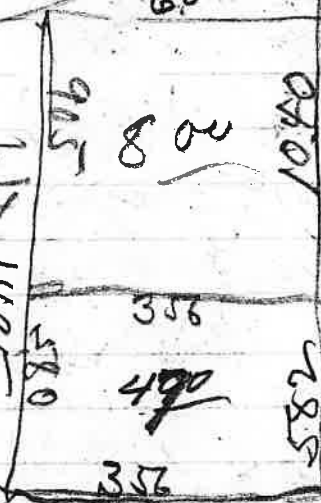

972	1040
486	905
<u>1458</u>	35 87
534	
5832	534
4374	<u>35</u>
<u>729072</u>	2670
778572	1602
19	<u>18690</u>
7.97	66) 1622 (24.58
470	356 (5.39
	260
	198
	620
12.67	66) 1485 (22.50
	132
	165
	132
	330

Hill

South	1622	ft.
Nest	356	"
North	1485	"
7708	400	

St. George

R B McKay

88

W from N2 cor of 24

S 89° 17' W 13/24

are. 39.60 1/4 cor.

for 48 S 45 E. 02

36 N 65 W. 53

total 5.88

~~1/4 cor for 1084° E 94 ft.~~

~~for 6 N 52 W. 145 ft.~~

2 | 39.60

1980

154

19.95

1300

00 11
10 7
058
250
100
100
100
250

R. B. McKay

89

Feb 28th 1943

Begin at a point 140 ft
North of the SE cor. of NE 1/4
of NE 1/4 of sec 24 T. 22 S
R. 4 W.

East.	300 ft	200 ft.	200
S 66° E	400		400
" 47 1/2° E	250		250
" 87 1/2° "	250		250
" 64° "	200		200
			1300

3/14-43

Begin at SE cor of NE 1/4 of
NE 1/4 of sec. 24

E from cor due 1320 ft
new post South from cor 78
ft to bey pt. N. 147 ft
leg of former survey

S 80° E 147 ft E. N line

Palmer

90

Lots 3-13 Lot 4

88 4 88 4 of sec 9

Tp 22 S R 8 W

Less Highway

Lease survey

Sherman

For Sam Brown

\$ 89.28 78

" 40 8 300 91

\$ 86.4 Cr. 30 ft

" 86.4 E 226

" 83 E 185

" 68 " 238

\$ 72.28 315

" 75.2 " 290

" 75 " 106 & wire

fence North 223 & fence

Cr 86.8 E 100 ✓

" 82 " 141 ✓

" 43 " 1138 ✓

" 44 (43) 645 ✓

" 53 " 251 ✓

" 73 " 100 ✓

" 82.4 86.4 RA

Sum
6.15
3.00
4.50
6.00
19.65

92

McKay

93

S 89° E 78 ft
S 40 E 300"
" 86½ " creek 30 ft
" " 226
" 83 " 185
" 68 " 238
" 72½ " 315
" 75½ " 290
" 75 " 106 to fence

N. S.
North from line to cor 223

S 68½ E 100 ft
" 82 " 241 " sent to
" 43½ " 1138 " McKay
" 44 E 645"
" 53 " 257"
" 85 " 390 "
" 54½ " 312"
N 82° 93 " to Co Road

Baldwin

94

E from N.E. way 16

20.12 fir pool marked

for 10 N 48 W. 26 1/2 ft

10 S 45 W. 16 ft

Wich from air

N 2000 for steps
marked for 1585
E 9 ft.

B. 95
Curl Binder
Apr. 13, 14, 16, 17, 23-24/1943

Begin at S.E. cor of
sec 2 Tpt. 22 & R 7 W.
at this cor two old bear
ing standing and a
cedar stake in place
set by a surveyor
Lee Barker

Run North from cor.
along gentle western
slope Var. $21^{\circ}40'$ run
W of old line. 41.30 to
supposed old cor. No bear
ing trees to be found. Set
a fir post 5 in eq 4 ft
long

Run N from cor.
Begin at S.E. cor of 2

and run west.

40.00 no trace of old
cor to be found. marked
clear to East of cor 15
Steam SW C SW East of
corner. At 80.00 no trace
of old trees to be found

Returned to 4 cor and
run south 2.00 top den
10.50 ft of hill 1340 road
C. E. W. 16.50 Elk Creek.
Course null.

Begin at S.E. cor 2 run
South down along on W. slope
40.00 first ^{thick} stone No trace
of old trees. West from cor
desc 10.00 foot of hill
10.91 for point but 8 12 E 25 feet

35-14 West
marked Elk Cr.
not marked
6 hrs 2800 ft
clear 6 hrs

11 11 11 11 11 11 11 11

E. G. Whipple

July 15, 16, 19, 20 & 21 1948

Began at the 4 sec. cor. on
W side of sec. 2 Tp 22 S R 5 W

North from cor. Var 21° E
at 1998. A cedar post set
by a former survey 39.48
sec. cor. A large & few
post in place.


Returned to cor 20.12 E
at 4 cor. and run North
20.02. at 20.08 N. old stake
N 1/4. 06. (bearing trees in
cool survey) West from
corner. 19.89 Int. N of cor
6 lks. Went to N 1/4 cor of
sec 2 Run East on Tp line
260 stream 5 W. e N. step

July 24th 1898

Carl Bender

Begin at post marked
1080 on E side of Cr
West 1000 to 8th section
for Cor. Run North 24.11
Nor North of center of Cr.

Thence West to N. 13 line
and run chain this line.

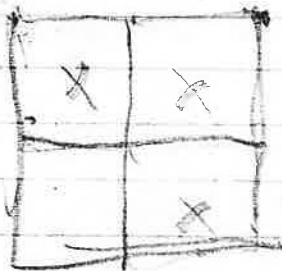

July, 1943
E. S. Whipple

31.00 stream 5 W. C. NW.
steep brookly asc. W. slope
40.00 no trace of old trees
61.00 Int NW to car get
for. Cool survey. 90 lbs.
Moved to car stake North 30
lbs.

R. E. McKay

Aug 1st 1943

Road Survey

South 76 E 270 ft

" 41 E 575

" 36 " 1892 "

" 55 1/2 " 310 "

" 47 1/2 " 126 "

" 32 1/4 " 269 "

" 47 1/2 " 319 "

" 42 1/4 " 195 "

" 82 1/2 " 432 "

" 55 " 500 "

" 69 1/2 " 88 ft

n. side of Co Road

R. E. McKay
Aug 1st 1943

Begin at N.E. cor of
section 24 T₂₂ S₂ R₂
3rd. New post.

West from cor. 10.15
stream 3 W C S. 19.95
new post.

for 10 S 4° E 14 lks.

South

400 stream 6 W C E

Enter N of to cor. 20

new post west on N & S
line.

102

A very please
let Mr Thiel
see the descrip-
tion of my
place

J W Haines
NW cor. of 44 E 44.68 N 353
E 500 N 347 E 9.25 S 19.94
N 891 S 579 N 50.26 N 18.51
to beginning Cont. 112.61 acres

Elva Littlepage

Survey in sec. 20
Tp. 21 S R. 4 W.
Sec. 29 & 30 1943.
Begin at the NW cor
of sec. 20 all old trees
gone stumps of 3 trees
found set on iron
shaff. $3/4 \times 30$ " in ground
North from cor. did not
chain. did not find
4 cor.

Returned to sec cor. and
run S $89^{\circ} 2' E$. 2000 wire from
S 4.35 set cedar stake
East 14.46. thence S $52^{\circ} 2' E$ to
RR. Return to sec. cor. and
run line West about 2000
and set stake on line.

Sp 23 8 74 ^{W 49} ²⁴⁵ ²¹⁹⁸
 732 2149
 Alvin Baldwin

Nov. 2nd 1943

Begin at to cor set by a
 section survey at 20.20
 S. of N.W. cor of sec 10
 and run line North to
 sec cor. 1750 cr 25 W
 C N. 19.95 intersect W
 of sec cor 98 lbs. set over
 for cor. Saw tree standing
 but dead (unmarked).

at to cor. put stake against
 a fir 40 in diam. (moved
 the stake E. 74 for true line
 Run East from cor (8898)
 2000 set a fir stake on N
 slope of cor 100 20 105

Nov. 6th

Begin at to cor Run South
 2000 set fir stake on
 flat East 1500 to

C N-S base on East
slope 2000 feet stakes
marked for 5 N 6.8 ft
marked 4 S.B.T

Catching Randall Road Survey

Nov. 29 1943

Begin at bridge over
Billy Cr. 00

✓ S 69 W - 295 ft

✓ S 83 " 312 "

✓ 4 65 " fir tree 431.5

✓ N 83 2 " 158 "

✓ S " 63 " 130 "

✓ S " 56 2 " 144 "

✓ " 80 " 74 "

✓ N " 83 W 170

✓ S 54 2 " 174

✓ " 78 8 W 284 mag

✓ " 87 " 339

✓ " 76 2 " 100

✓ " 46 " 144

✓ " 74 2 " 72

✓ " 2 7 6

✓ 107

56 52 1/2 W 126 ¹⁰⁸
 21 52 3/4 " 5.33
 center of cy 25 ft
 54 1/2 E N 123
 across cy cy 88. m
 84 98 rock flags
 ls n 46 1/2 E 497

 S 26 1/2 W 225
 13 5 W 343
 18 2 E 197
 8 8 W 158

 18 6 1/4 " 224
 11 18 " 175
 11 13 " 340
 11 17 " 194
 11 2 E 152
 11 47 " 178
 11 29 1/2 " 118

2 6° S	132
(21) 8.7 W	82
1 57 " at 80 ft center of bridge	235
<u>crick</u> 846' 2" 103 center of cr course of old bridge to S 40 ft.	733
8 28 W	214
8 27 W ^{S 27 1/2° N 629} by big log	415
Summit	197
5 35 W	235
3 32 W	130
8 53 W 85 ft	144
to drive fence	
to sta no 37	
	109

Lower Sec. West
600.

N 151

N 130 center of CV

" 200 peg 9375 E.
side of Co Road

North 11° East 474

flaggs brs. S 102° W.

North 12° West 389

flaggs brs. S 1° W.

North 11¼° East 3,39

to iron peg

flaggs brs. S. 13° W.

marked

a pin 12" N 19° E 86 ft.

" " 10 8 22 " 68 "