


# DOUGLAS COUNTY SURVEYOR'S OFFICE

ROMEY WARE, COUNTY SURVEYOR

COURTHOUSE ROOM 105-A  
ROSEBURG, OREGON 97470  
(541) 440-4272

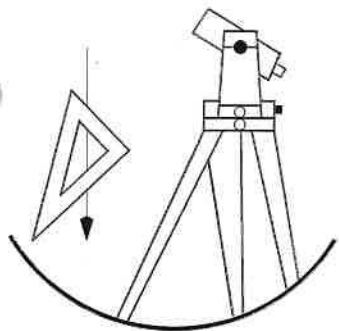

July 28, 1998

To whom it may concern:

The old Field Books of O.F. Thiel, PLS #4, have been in the office of the County Surveyor for a number of years (the exact number is unknown to me). They have recently be plotted and index cards made for them.

I began going through them in the fall of 1993, when time allowed it. Due to a recent court case it was determined that it was important to plot them the best that we could. Not all of the surveys are plotted, some pages are extemely hard to read, and others are hard to follow.

Jean H. Crawford  
Survey Technician  
D.C.S.O.

T - R	Sec.	Page	For/Title	Date
0-0		3	Jespersion	
T20-2	32 ♥	37	Lane Co. - Wm. Kelley	12/11/28
T21-4	16 (SE) ♥	36	Martin Anderson	9/13/28
T21-4	28	33	Bert Delauney	7/21/28
T21-4	28	43	Benj. Watkins	1/5/30
T21-4	32 ♥	39 - 40	W.C. Henderer	12/28/28
T21-5	12 ♥	31 - 32	Pioneer Lumber Co.	4/28
T21-5	28 ♥	38	Perkins & Beebe	12/13/28
T21-5	31 (S¼) ♥	51-52	Harry Haines	1/15/31
T21-5	33	22	Mary Perkins	3/29/27
T21-5	33	54	Minnie Krewson	
T21-5	35 ♥	20 - 21	N.D. Cool	3/25/27
T22-3	5	35	Lane Co. - Krewson/Clark	11/15/28
T22-4	21 & 28 ♥	30	Jas. Cox	11/27
T22-4	31 & 32 ♥	45	J.G. Applegate	2/3/30
T22-5	2 ♥	20 - 21	N.D. Cool	3/25/27
T22-5	3 ♥	4 - 5	N.A. Koepka	8/17/26
T22-5	4 & 5 ♥	23 - 25	Floyd O. Craig	8/27
T22-5	6 ♥	51-52	Harry Haines	1/15/31
T22-5	17	6	H.L. Cowles	8/23/26
T22-5	31 & 32 ♥	10	Leeper & Ohlson	10/21/26
T22-5	31 & 32 ♥	18	J.T. Miller & Ohlson	2/16/27
T22-5	35 & 36 ♥	7 - 8	Cochran Bros	9/23/26
T22-6	1 ♥	51-52	Harry Haines	1/15/31
T22-6	24/25 ♥	41 - 42	Whipple & Harlan	2/6/29
T23-4	? ♥	14	J.A. Forbee	
T23-4	5 & 6 ♥	45	J.G. Applegate	2/3/30
T23-4	19 & 20 ♥	11 - 13	Pringle Bros.	11/26
T23-4	19 ♥	19	Ed Douglass	2/7/27
T23-4	30 & 31 ♥	9	Albert Cochran	9/23/26
T23-5	2	44	R.W. Davis	7/16/29
T23-5	5 & 6 ♥	10	Leeper & Ohlson	10/21/26
T23-5	6 ♥	27 - 29	J.T. Miller's Est.	12/27
T23-5	24 ♥	19	Ed Douglass	2/7/27
T23-5	25 & 36 ♥	9	Albert Cochran	9/23/26
T24-4	9 & 16 ♥	15 - 17	E.A. Davidson	1/27
T24-4	26 & 27 ♥	26	S.S. Schell	10/13/27
T24-5	39 DLC	34	E.R. Stevenson	7/28/28
T25-4	10 ♥	46 - 49	Eliza J. Rone	7 & 9/30


♥ Denotes Government corners set & BTs marked or re-marked.

♦ Denotes pages that are hard to read or can't be read.

♣ Denotes that the survey is similar to , or the same as the map number given.

This is a rough index for the field book

Field Book #116

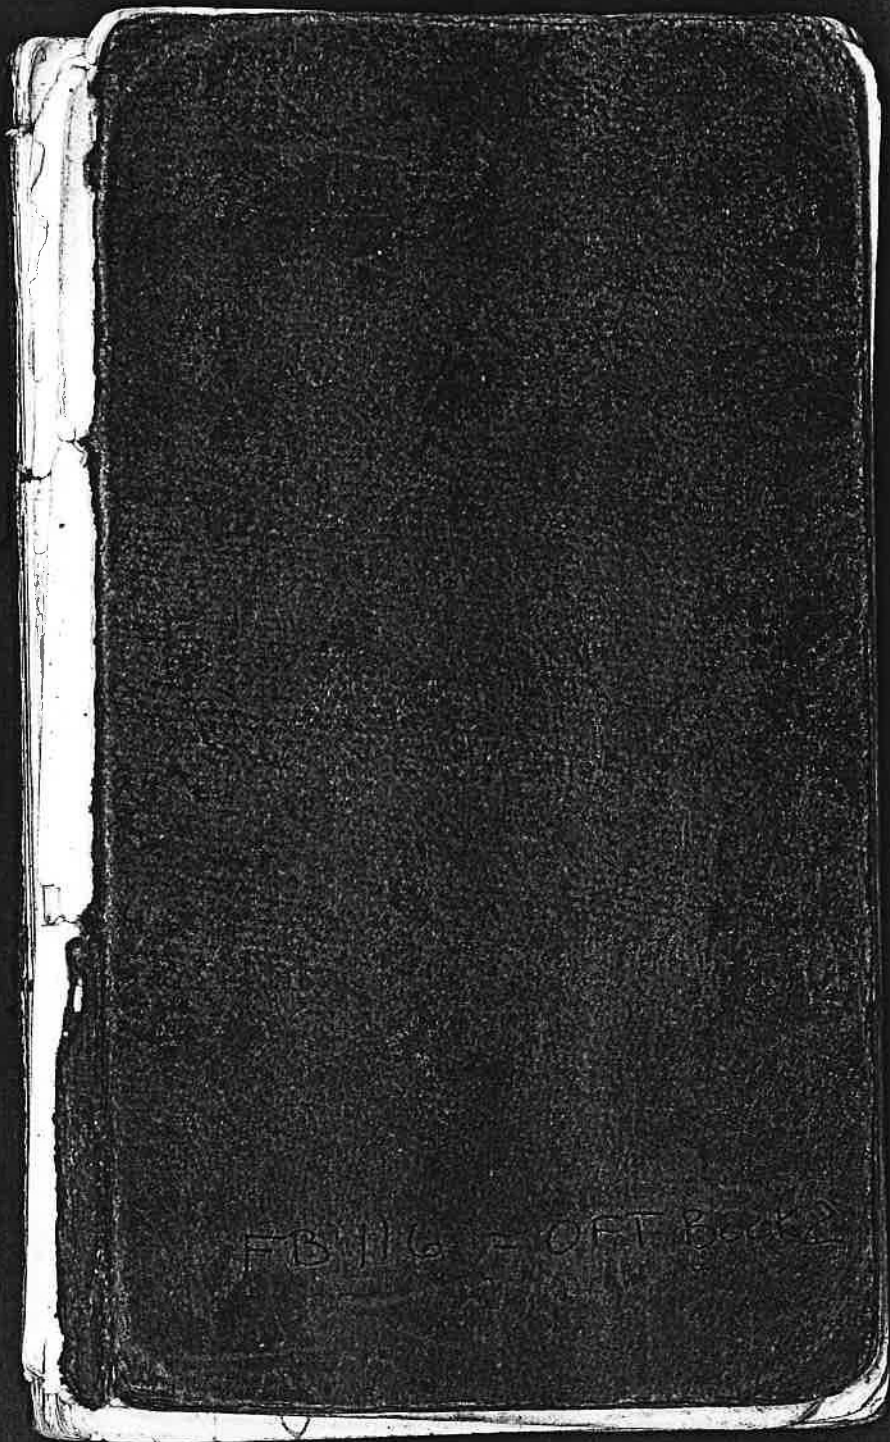

FB 116 - OCT 1962

FB 11 6

Propertys  
of

O. A. Thiel  
Surveyor.

Yoncalla, Oregon



J. Jepperson

Contd.

Intersect E of 4 cor. 92-  
NE tree standing found

old marks.

at 20.30 and 46 mark

red top post.

marked for 8 & 47N. 09.

" 10 71 569 08

at 19.91. East of the N.E.

cor. of 20 north North.

across field 20.10 post

on steep hillside Run

line east across field

sides into old vineyard

to the cor. Line run out

center of Jackson's

house. West to a point

2000 ft. of N.E. cor. of

21 and thence across

pasture to 21 line in-

tersect a little north

of E. side line 21

of Boy old line 21 10/45

Aug 17th 1926  
4th

M.A. Koepke

Bequest ad N.E. cor 7  
acre 10 1/2 ac. S.R. 5214  
cedar stump box 76 7/8  
17 1/2 ac. from cor 7  
2 1/2 ac. 4045 - Entering E  
of 4045 cor 7

Busby moved back  
S. 1/2 - 1/2 cedar tract  
marked for S. 841 N. 26

" 12 N. 48 N. 15  
Barn West. Year 713 1/4  
Dec. 165 - 165 - 165  
bl oak S. 80 or 85 W. 50  
1/2 ac. 1/2 acre 700 ft. of  
dike abt 1300 long del

1675 ft. of overland  
cedar tract marked  
Jan. 24 710 E. 57  
1/2 N. 1/2 from cut  
1/2 N. 1/2 ad  
960 top steep desc.  
12.50 ft. of "

5

M.A. Koepke Contd

20.00 cedar book marked  
Jan. 14 711. 17 E. 19  
" 60 " 76 W. 35

Each from cor  
through timber. rough  
20 15 Entering cor. 86  
from 4 cor. chained  
North along line of fence  
S. 1/2 - 1/2. 26. 00 S. 1/2 - 1/2  
marked. Dec 16 715. 58  
cor attached on E slope  
fence North of a big log.

6

242 Cowles

Aug 23rd 1926.  
 Begin at the 4 sec  
 cor bet 17.18 2p. 2nd 17  
 5th North 133 feet  
 209 to bank for 100. W  
 along fence 2.05 72  
 9 sec. East 205 to sec line  
 from sec line 6.4 base  
 208 1/2 North 354 to cor  
 East 4.15, then 1.63 S  
 180. S 85° E. 85 to East line  
 of horse land.

7

Cochran Bay

Sept 15th & 23rd 1926  
 Begin at a cedar  
 post East (40.00) of the  
 4 sec. cor. 671 23rd 34-35  
 2p. 22.8 11.5 W chained  
 9 from post 40.25 70  
 trace of old bearing tree  
 to be found. Next to  
 sec. cor on North S.E.  
 bearing tree standing  
 (remarked same) stump  
 at N.E. 2d NW tree joint  
 10rd a cedar post  
 Chained to the south from  
 sec. cor. 40.21 sec. a cedar  
 post for cor. marked a  
 double cedar 22° S. 68W  
 97. 1st cor. 4 sec cor. var.  
 230.05. Remarked chained  
 W. to 4 cor.  
 From 7 sec cor. var. E  
 var 23° 05' along N. slope  
 dead. 20.10 set a cedar

Ponds for to cor on N  
 slope - marked -  
 for 40 N 11° E 107.  
 maple 12 & 73° W 154  
 var. cor 76 cor. 230.

Albert Cochran  
 Sept 23<sup>rd</sup> 1926  
 Begin at the N.E. cor  
 of Sec. 36 Sp. 22 & 15 W  
 from West from cor.  
 through slashings and  
 pasture. At the N.E. cor  
 of 36 cedar tree re-  
 marked N.E. tree a  
 second S.E. stump N.E.  
 82 1/2° E. marked for 18'  
 S. 44° E. 63 40.00 no trace  
 of 4 cor to be found.  
 Cedar tree - marked -  
 wh. post. 18 S 40 E. 35.  
 at 76 cor E. - marked -  
 double for 20. S 42° 78.  
 from line South

## Leiper &amp; Chisoom

Oct. 29<sup>th</sup> 1926

Begin at the 4 sec. cor.  
bet sec. 5<sup>th</sup> 3<sup>rd</sup> 3<sup>rd</sup>. or S side  
of 3<sup>rd</sup> Tp. 22 S. R. 5 W. cor.  
led. by former survey.

Went on Tp. line clear  
timber intersected a little

S of cor or old post set  
top C.S. set a new post  
and marked fir 16' N. 76°

42. run line N. across  
valley. Returned to 4 cor.  
and run line North

Var. used 21° intersected  
24. of cor set. by former  
survey. 70 lbs. moved cor  
W. set. 70 set. a fir post  
marked fir 40 N 10° E. 38  
" 24<sup>th</sup> South 12.

Var. used 21° E.

48 00

## Poringle Post.

Nov. 3, 4, 5, 9 1926

Begin at the S.E. cor of  
sec. 19, Tp. 23 S. R. 4 W.  
S.W. and N.W. tree zone.  
set a cedar post.

Var. used 23°

Went from corner.

335 stream C.S.E. steep asc.

28.50 top of ridge. C.S.E. N.E.  
dead N.W. slope.

40.25 Enter S. of 4 cor. 10.

S.W. tree cut down  
Found old marks on N.W.  
(Spec'd) tree. remarked  
same. set a cedar post  
and marked a pit. 20 S

84° N. 38.

North from 4 cor.

Var. used 23° (2.14)

along on N.W. slope.

40.25 Inter. N. of cor. 1121

Run E. from cor.

Tring le B. Contd.  
Inter. N of 4. cor. 2.33  
Set a cedar post at  
4 corner.

From 4 cor run N.

from cor. Run line on  
Var. 19 $\frac{1}{2}$ . Intersect at.

cor. set on N-S line, at

40.25 moved temp cor E

1.21 set a yard post and  
marked. for 12 N 32° W. 30

Cedar E S 98. 19

" Var. 23° E.

Begin at 4 eye. cor and  
traced old line N. to see.

cor. old post in place trees  
standing Run E from

cor on bluff line. 20.13 set

cedar post by an old log

marked a cedar 12.75 at 24.

" " " 45 S 18° E 38.

South from cor.

Var. 21 $\frac{1}{2}$ .

Tring le B. Contd.  
through heavy timber

40.25 set temp cor on flat,  
Begin at 4 cor run  
N. E.

18.27 Int. N. of temp cor. 08

Moved temp cor East

1.76 and set a cedar post

marked. for 48 S 73° W. 20

" " " 8 73° W. 27

Begin at cor in

center of eye 19 run

W. post used 19 $\frac{1}{2}$  at

stake marked

on alder 10 S. E. 10

maple 12 N. E. 30.

2013

\$ 17.00

15.00

2.00

OB

due

J. A. Trobber  
Twp. 23 S. R. 4 W.

Began at NE cor of said  
land. Marked.

fir 12" N 78 1/2 W 15  
" 12" " 7 E. 07

South from cor.  
20' 35"

Nor by line S. 20' 35" W

5:29 N. side of R. of W. of Co road.

S 59 1/2 W. 3.78 West 3.93.

S 85 W. 3.82 to E side of

old Co. road, N 12 1/2 W. 5.12

N. 37 1/2 W. 3.60 to line fence

cedar feet marked. 1.63

cedar 15' S 79 E 1.05.

" fir 18' S 10 W

" spr. 20' 35" E.

Chained W. from to cor on

hill 6.43, S. 13.42 to line fence

Trobber's N. line 7.00 E to N.E.  
cor. and should be 6.48  
Beguinson 8.42 S - 5.76 E  
to cor be 16 1/2 N.

E. A. Iguison  
Twp. 24 S. R. 4 W.

Began at the 4 sec cor  
bet 9-16 set oak post.

by N. P. bearing tree  
(trapele remarked) marked

cedar 10 S 85 E. 30

South. Var. 21' which

set oak post from which

fir 18 N. 57 S 15

oak oak 5 S 62 W 10

East from cor. 600 ft from

C.S. very steep incl. 22.50

set stake, did not run

this line any further

Jan. 26 & 27 92.7

Began at 4 cor bet 15-16

marks on NE tree

N.W. tree fallen

North Var 21'

tree steep incl 12.25

top of ridge, along on

2010

16

Jarvison Contd.  
 N. slope 20.10 fir stake  
 marked fir 24 N 79 E 34  
 " 24 S. 9 E. 55  
 followed old blazed line  
 Begin at 4 cor run  
 East from cor. desc. along  
 through open. 20.50 top of  
 ridge S. 40 stem C.S. J  
 27.60 stream C.S. 40.00 top  
 cor. heavy timber  
 60.30 fir stake on top of ridge  
 marked.  
 fir 12 S 45 W. 34  
 W. fir 18 N 77 E 26  
 South var 21°  
 steep and brushy desc.  
 stake edge of opening,  
 East. steep fall.  
 to N.E. cor of cl. 46 m.  
 14.53 traversed at corner S.W.  
 tree dead but standing

17

Jarvison Contd.  
 Laurel N.E. 45 lbs.  
 marked fir 18" N.W. 95  
 corner stands E of top  
 of ridge  
 of South. Var 21. desc.  
 stake on steep hill side.  
 Went to S.E. cor of cl.  
 a fir 18" in diam stands  
 at corner. Two N.E.  
 trees standing S.W.  
 gone.  
 Returned to stake on  
 hill east 12.50 S. of to cor  
 and open line South.  
 through opening to line  
 of blaim. dig not  
 Jedain this line.

7.50

5.18 50

F. J. Miller & S. Phalon  
Sp. 23 S.R. 5 W.  
Feb. 16<sup>th</sup> 1927.

Begin at S.W. cor of sec 32  
cut. in place.

North Var. used 21°.  
Up on hill stream W.

Top of ridge

Black oak post from which  
fir 10" N 17° W. 28 lbs

Laural 6" N. 88° E 13"

Post var 21°. desc.  
stream South side

larger fir top.

Top black oak good top  
20.00 oak post in ravine.

masked <sup>100</sup>

wh. oak 7" N. 11° 13 lbs.  
" 12" N. 83° E. 13 lbs.

North from cor.  
Run line North to top  
of ridge. did not chain

\$8.50

Ed. Longlass Var 1920  
Sp. 23 S.R. 4 W.  
Feb. 7<sup>th</sup> 1927.

Begin at 76 cor. post. by  
the Poirable Survey.

steep asc. 2.00 top desc  
stream 12 W. C. S.W. asc.

steep asc. E. slope.

Sp. line. Intersected  
155 North of 4 cor.

S.E. bearing tree gone but  
a young fir in place of  
old. marked the red  
tree.

Post from 4 cor. did  
not chain Var used  
202. Run to creek.

1700

22.78

\$8.00

## N. D. Coal

- Feb 22 S R 5 W  
 March 25<sup>th</sup> 1927.  
 Begin at 4 sec. cor bed  
 2 and 3. Var. 21 1/2°  
 East from cor.  
 20.12 set a maple post. marked.  
 a maple 12" N 48° W. 12  
 South from cor.  
 see fir timber  
 20.12 set fir post on top of ridge  
 marked fir 16" N 32° E 27.  
 " 24 S 59° W. 06.  
 Begin at N.E. cor. of sec 2.  
 post. in place. West from cor.  
 Var. used. 22°  
 13.70 stream c. n. young firs.  
 20.12 cedar post on flat  
 marked fir 36 N 10 W. 07  
 " 10 S 27 E 15

48.00

## N. D. Coal contd.

- March 28<sup>th</sup> -  
 from 76 cor on Sp. line  
 South from cor. Var 21 1/2°  
 see small fir str-  
 set stake - marked -  
 bl. oak 30" S 77 W. 83  
 a fir 10 " 5 1/2 E. 25.  
 cor stands near top ridge  
 Run South, enter larger  
 str did not chain this 40.00.  
 divide bed. Elk Pass creek.  
 Went to 76 cor 40.00 West  
 and over East, did not  
 chain at intersection of N. 12.  
 line set fir post - marked  
 fir 46" S 58° E .14  
 " " N. 48 W. .21  
 Cor stands on S.E. slope  
 at 76 cor E. of 76 cor Run  
 North Var 29 1/4. 45 stream c. 76  
 76 cor fir stake - marked -  
 wh. fir 12" N 18 E .16  
 " 5 S 20 W .17  
 19.00

20.15

Mary Perkins

H. 21<sup>st</sup> S. R. 5<sup>th</sup> W.

March. 24<sup>th</sup>. 1927.

Begin in at  $\frac{1}{2}$  cor. N. of  
4<sup>th</sup> Sec. 33<sup>rd</sup> E.

Run N 89 $\frac{1}{2}$  W. var.

used. 21<sup>o</sup> followed old  
blaze of line followed old  
blaze of ground. post. at  
40.00. - thence L

South from cor.  
May 21<sup>o</sup>. Run South  
to line fence between  
Perkins & Tracy. In-  
tersected East of wire  
fence. 06. Leave timber.

\$5.00

Floyd O. Craig

H. 22<sup>nd</sup> S. R. 5<sup>th</sup> W.

Aug. 18, 19, 20, 22, 23, 25, 27.

Begin in at S. 1/2 cor. of 4<sup>th</sup>  
re-marked. W. of tree  
cor. at place by E. S.

Var. 21<sup>o</sup> 35' North 1<sup>o</sup> E

from cor. are steep upon  
hill side 15.00 top 20.18

each post marked a  
double mark S 20<sup>o</sup> E. 22.  
E and S. of stake set by E. S.  
Run N 89 $\frac{1}{2}$  W.

500 top along N. slope.

22.00 top of divide. N. W. S. E.

60.00 stone in mound of  
stone. (in canyon)  
marked cedar N. W. S.  
his S. W.

N. 1<sup>o</sup> E. from cor.

steep grad. 10.80 top.

marked. 18<sup>th</sup> post.

marked. 9 maple. 18<sup>th</sup> N. W. S.  
W. 14. made 20 S 79<sup>o</sup> E 15

4000

## Craig Contd.

Begin at 4 cor. tree  
546 both trees standing  
cut into N.E. tree

Run E. from cor. 585  
top along S. slope very  
steep, dike to ~~the~~ line

18.65

N. S. line.

From this line the line  
E to 4 cor on East, on top  
of mountain to S 87½ E,  
thru N. from this line

20.00

set post.

Run line S 89½ E to  
¼ cor. Inter N. of cor. 124  
corrected line back to cor.

Begin at S.W. cor. 4  
Run S 89½ E. and Inter.  
S. of 4 cor. 24. Iron bolt  
in place new tree stand-  
ing  
moved to cor E. 20 and

4038

## Craig Contd.

North 12 set a sawed  
post marked. —  
with oak 8" S 64½ E 47

dir 20° N. 7½ W. 92

North from to cor. a/c.  
Lynke cor.

20.00

chained on N. across  
pasture to E. old line,  
temp stakes.

39.50

Went to 4 cor. ~~top~~ hill  
and chained along ~~top~~  
each 19.58 Inter. N. S. line

.60 S. at.

and 21 E set stakes  
and marked a

19.70

maple 8" N. 2.

S. S. Schell

Oct. 13<sup>th</sup>. 1927

Tb. 24 S R. 4 W. 7

Begin ab 4 cor bet sec

26 &amp; 27 found stumps of 4

E. trees and S.W. (as did stand.

ing. remarked both trees.

North from cor. desc. var.

used. 26° 45'

40.30 no trace of old trees to be  
found. In old park found  
East of line along will fence.

Returned to 4 post and run

S. var. Var. used 120'

11.50 top of ridge &amp; desc

20.05 Entered E. of stone cor. 24

Ran W. from cor

2000  
temp cor

Went to 76 cor on the South

Var. 20' over broken country.

19.54 Inter E of temp. 9 lks  
19.91 from E bet a fir post for ex.

J. J. Miller's Coax. 1927

Nov. 23<sup>rd</sup> sec 1<sup>st</sup> and

Tb. 22 S R. 5 W.

Begin at the S.W. cor of

sec. 32.

Went on T<sub>h</sub> L<sub>y</sub>ric var.

used. 21° 14' 15" temp cor

Begin ab bearing tree

at the 4 cor of sec 16 and

run T<sub>h</sub> L<sub>y</sub>ric Coax. 5:87 +

1413. Intersected North of

temp stake. 35' moved

stake South. 17 1/2' near

Willow bearing tree mark  
ed. E.S.Dec 10<sup>th</sup>

Begin at the center of

sec 6. Found stump of

bearing tree to cor cyl

down &amp; re-established

cor. by setting a cedar

post (found old stake)

Marked a new bearing

J. J. Miller's East Contd.

a fir 28" brs. N 11° W.

85' var. used 21°

Run N. 89½° E.

14.85 center of Co. road c. N. S. 88.

18.25 " of creek c. N.

20.00 temp cor in field.

37.87 Entrench N. of 49 cor 12

old stakes in place.

both old trees gone.

marked a bl oak 40 S. 86

W. 16 links. (cor stand

on top of ridge)

1993 moved temp cor S. 06

marked.

wh. oak 24 N 45 W. 99

" " 24 S 16½ E. 08

Begin on section line  
at the intersection of S  
line of claim N 45

along wire fence

20.00 run South 9.90 and

J. J. Miller's East Contd.

Hex 179 to wire fence.

corner in prairie field.

20.40 Intersect East. of Cor. 22.

at this corner marked

a fir 28" S. 23 E. 08

" " 20 N. 62 W. 18

var. used on this line. 19°

corner stands on E. slope.

Jas. Cox  
Nov. 4<sup>th</sup> 1927.  
Tp. 22 S. R. 4 W.

Begin at a stake  
and 10.00 W. of 4 sec. cor.  
on north side of 28 sec.  
by Stephenson's Survey.  
at jaw post.  
find 5 W. W. 3.

South from corner  
bar used 22° arc.

- 20.12 fir post marked.
- fir 45" N 10' W 18
- " 36 S 1 1/2' N 60.
- S. 89 1/2' W. along N. edge
- 10.00 cedar post marked
- fir 16 N 76 W. .10
- " 20 S 40 E .08 1/2

Pioneer Lumber Co  
Apr. 9<sup>th</sup> and 13<sup>th</sup> 1928.

Apr. 21 S. R. 5 W.  
Begin at the S. E. cor.  
4 sec. 12. post in place  
set by former survey.  
Plat. used 2 1/4'.

Run west on line  
line appears to bear a  
little South.

39.94. 4 cor. set a fir post  
remarked both old trees.  
from 4 cor. W. seems to fall  
low old line

80.42. Int. 4 lbs S. of cor.  
North from cor. decr 7' 30  
Bar used 2 1/4' from 7' 30  
E. followed old blazed line  
48 cor. stands N. of Magellane

Set a fir post and  
remarked N. E. tree S. W.  
tree dead.

Pioneer L. Co. Conter

From the  $\frac{1}{2}$  cor run

East. Var. used. 21 $\frac{1}{4}$ .

old growth timber

7900 stream 5' c. m.

46.25 est a fir post.

marked a fir 24' N. 47'

E. 39 lbs.

fir 5" diam 5 lbs.

continued fine E. cor.

with out. chaining

and interested  $\frac{1}{2}$  cor.

24 lbs. S. of cor.

timber  $\frac{1}{2}$  brush.

Wm. Zimmerman

W. V. Chapman survey

Burt Delaney

July 2<sup>nd</sup> 1978

Begin at the S.E. cor of

the S.W.  $\frac{1}{4}$  of a  $\frac{1}{4}$  of

sec 28. from which a

log was 10' S 7 $\frac{1}{2}$  N. 73

North from cor.

Var. used 20 $\frac{3}{4}$

675 stream 15' W. C. W.

867 to center of Co. road

marked cedar 10 N 21 W. 38

double cedar 18 N 41 E 71.

S 64° E 873 S 44 E 657. to

hence line S 89° W. 1244

to beginning

E. R. Stevenson  
July 28<sup>th</sup> 1928  
Tp. 24 S R. 5 W.

Begin at a stone post  
S. E. cor. of N. S. Allen  
Co. No. 39. A wh oak 16'  
stands S. W. from stone  
marked by E. S.

Run S. 89° E. along wire  
line. Var. west 20°  
E. side of Pacific High.  
way R. of id.

620 edge a dir post. marked  
wh. oak 8' N. 27° W. 19

North from cor in pine  
stake. N. 89° W.

to Right- by way. Sub

along R. of W. oak. Sub

S 28° W. 300' S 23° W 190  
S 12° W. 286' to cor.  
containing 3.60 acres.

O. L. Kreyenborg and  
J. D. W. Bee. Clark  
Tp. 22 S. R. 3 W.

Nov. 15<sup>th</sup> 1928.

Begin at a stone <sup>on the</sup>  
side <sup>of</sup> the  
center of section 5<sup>th</sup> cor. by  
E. S. Run East 2000.

South 2000. East 2000 &  
blazed line running N. S.  
set dir stakes at all corners  
but did not mark any  
bearing trees

marked off. 4 and 2 were  
taken. 4 bare for Kreyenborg  
and 2 were for Leo. Clark  
Var. used. 21°

At the beginning point  
a stone in ground a dir  
stump 86. (45 in) N. 52° E.  
57 lbs.

4 acres lies in a square  
and 2" " on W.

Martin Anderson

Sp. 21 S. R. 4 W.  
Sept. 13<sup>th</sup> 1928

Begin at the NE. of sec.  
16. found marks on N.E.  
stump and S.E. tree (dead  
marked.

hemlock. 22" N 11° W. 10

dir 8" S. 24 E. 42

This cor. is S. of the Pacific  
Highway about 2.50 on

N slope of hill.

Run the line North from  
Cor. RR fence.

Jim Kelly

Sp. 20 S. R. 2 W.

in sec. 32. Dec. 11<sup>th</sup> 1928.

Begin at a point on S.  
side of section 32. At this  
point the old bearing for  
the 4 cor. Feb. 5-32 are gone.

found holes in ground  
corresponding to description  
and direction in field notes  
set stone in place.

North from cor. Varied 21°

Interior cor of cl. 38 hrs W.

12.3. set claim cor by N.W.  
bearing tree

North side Boone River

Center of highway N.W. SE

set stake in place

7.71

31.68

23.10

40.00

Parkins & Beebe

Feb. 21 S. R. 5 W. 28.

Dec. 13. 13th 1928.

Begin at. 4 cor. bet.

28 & 29 both old trees

dead. N.E. cut down &

N. W. fallen. found

old marks on both stumps

set a cedar post

and marked.

a cedar 18" N. 86° W. 26

a fir 22" " 18½° E. 29.

Ran East. Van used 2'

followed old blazed line

at 40.00 Cedar post

remarked S. & trees

maple. 8" S. 35° E. 39.

Cedar. 12" S. 24 W. 14.

This tree has (maples) S 7 E. 31

Survey for J. L. Johnson

part 26th 1900.

W. L. Henderson

Dec. 28th. 1928.

Feb. 21 S. R. 4 W.

Begin at a post in the

4 cor. on S. side of sec. 32.

on W. side of hill.

Northward cor. Jan 20/4

desc. through fir timber

20.10 set a cedar post and

N.E. of a spring - and -

marked. 1'

a cedar 24" N. 73° W. 22

a fir 19" S. 49° E. 15½

ascend. along on W. hill

side, very steep.

40.20 set a cedar post and

marked. a fir 30" S. 3° E. 29

cor. stands. North of pole line

Ran S. 89½° N. through opening

20.10 set a cedar post marked

a fir 15" S. 55° E. 16

This cor stands. 50 East

of Co. road & South Valley

J. S. Henderson Cont'd  
 South from 76 cor.  
 Center of Co. road, thence  
 S 26° E.

2.93	4.20
" 3 "	1.93
" 43 "	2.33
" 23 "	3.75
" 1 1/2 "	4.80
" 7 1/2 W	3.32
" 26 "	1.27
" 15 1/2 E	2.00
" 6 1/2 "	6.00
" 44 "	4.00
" 22 1/2 "	2.34
" 45 1/2 "	2.87
" 21 "	2.50

to see line  
 to cor is East 8.45  
 Meanders of Co. road

Whipple & Starlan 744  
 Feb 4, 5 and 6 1909.  
 The ad. S R 6 E.  
 Begin at the S.E. corner  
 of ad. 24 set an oak post  
 All old trees standing  
 Run line west from cor.  
 deer through pasture.  
 12.00 Kelly creek E. 90°  
 18.34 center of County Road. i. n. S.  
 29.04 Imp corner.  
 33.00 Top of ridge.  
 40.10 Intersect S. of 4 cor. 186  
 S.E. bearing tree standing  
 set dogwood post.

17.50 From S.E. of 24 West.  
 moved cor north on true  
 line set with oak post  
 marked  
 for 12 S. 80 W 7  
 " 10 East 6  
 At 76 cor N. of this cor.

Whipple & Garland with  
 oak post marked  
 cedar. 22" N. 24 W. 4  
 wh. oak 10" S. 20 E. 11

Benny Watkins  
 J. P. 4-5-1930.  
 J. P. 21 S R 4 W.

Begin at the S.W. cor. of  
 sec. 28. Old post set. by  
 E. S. but no trace of any  
 old bearing trees to be found.  
 Run East. from cor. 21° E  
 along on S. slope. 17.00 top of  
 ridge. 20.00 temp cor. along N.  
 slope 39.82 enter old post 106  
 North. 17.00 to a cor. post  
 set for J. B. Whitrick survey  
 N.W. cor of S.E. ¼ of S.E. ¼ of S. 8.  
 chained N along fence. 20.00  
 to stake. South. on line of  
 stake to old cor. 20.00 to old  
 cor. Set a pin post 9 lks E  
 of old stake 3 E of a fir stump  
 76 cor. West of 76 cor. moved.  
 temp cor. S. 53 and wh. pin  
 post for 76 cor. corrected line N.

R. W. Jarvis.

July 16<sup>th</sup>. 1929.

Began at the N.E. cor of  
 Colman Don. (stone) at cor.  
 of fence on bank of ditch  
 East farm cor. 4.58  
 North from peg across field  
 10.75 stream C. W. 19.38  
 peg on fence. & N. side of road.

The description reads.

East	4.58
North	19.38
S 69° W.	19.58
" 44° 4 "	17.50
East	26.00

Co road.

" 36.90 acres.

Tr. 23 S. R. 5 W.

J. S. Applgate

Feb. 3<sup>rd</sup> 1920.

Tr. 23 S. R. 4 W.

At the N.E. corner of sec-  
 tion 6 set a cedar stake  
 and marked.

An ash. 12" South 47 lbs.

" " 12 N. 30° E. 39 "

all of the original trees  
 gone. This cor re-establish

led from bearing trees

marked by a former

survey dated Mar. 7<sup>th</sup> 1906

where old marks on S. E. tree

or log were found.

a pine tree marked as a

witness tree for this cor.

burnt down.

Staked line across

quilt to East line.

Eliza J Rone

July 1, 23, 13<sup>th</sup>

Sept 23, 26<sup>th</sup> 1930

Sp. 25 S. R 4 W.

Begin in at N.E. cor of sec

to Sp 25 S R 4 W.

old rock and stone for cor.

Marked new trees

for 30 S 7° E.

" 32 " 79 W

" 20 " 11 "

" 12 " 57 E

South from cor

Var sided 20 $\frac{1}{2}$ ° E

to of ridge due

1900 leave timber

20<sup>50</sup> begin steep desc.

27.65 wire fence

27.85 stake in field

" 89 $\frac{1}{4}$ ° E.

13.04 claim cor. old bearing

tree gone marked

bl. oak 15" N.E. 05

" " 20 " N. 87 W 90

25

22 $\frac{1}{2}$

16

13 $\frac{1}{2}$

Rone Contd

East from E.L. cor. 4.00

South 1.62

East along old fence.

cedar stake marked

wh. oak 7. N. 12° W. 16 $\frac{1}{2}$

East. 1.68 $\frac{1}{2}$  cedar stake

marked. fir 24 S 14 E. 03

" bl oak 6" N 77 W 14 $\frac{1}{2}$

" N. 40° 45' E.

top of rice 505 grain field

stake in grain field

Var. 20 $\frac{1}{2}$  West from  $\frac{1}{4}$  cor 6 $\frac{1}{2}$  3-10

2.50 South. 10.71 East 2.50 to line

South. 92. N 41 $\frac{3}{4}$  E. 1.09

" 33° 20' E. 1290 water edge.

Begin on line witnessed by

fir 24 S 14° E. 03 bl oak 6" N 77 W 14 $\frac{1}{2}$

to West bank of creek.

Marked wh oak 6" N. 84 W 24.

" " " 12° N 9 " 23

cor. stands N. of water edge.

6.53

1.90

2.142

Var. 20 $\frac{1}{2}$

2.50

23.00

Rone Contd

July 13<sup>th</sup>. 1930  
 South fork & cor. 10.71 Temp's reg.  
 Run line South & S. valley.  
 Intersected N. of cor 19.

9/28-30

Begin at stake on W side of creek

N. 42 <sup>3</sup> / <sub>4</sub> E.	666	cr. to E	100
" 47 <sup>1</sup> / <sub>2</sub> "	170	" "	110
" 35 <sup>1</sup> / <sub>2</sub> "	306	" "	20
" 6 <sup>1</sup> / <sub>2</sub> W	308	" "	105
" 5 <sup>1</sup> / <sub>2</sub> E.	220	" "	20
" 12 <sup>1</sup> / <sub>2</sub> W.	237	" "	10
" 38 <sup>3</sup> / <sub>4</sub> "	231	" "	65
" 13 <sup>1</sup> / <sub>2</sub> E.	97	" "	15
" 8 W.	238	" "	35
" 36 <sup>3</sup> / <sub>4</sub> "	142	" "	75
" 66 "	163	" "	125
" 86 "	132	" "	50
" 57 "	248	& cor.	

At this cor set ash stake marked  
 double alder 12" S. 77 E. 19  
 Balon 18' N. 74° W. 52<sup>1</sup>/<sub>2</sub>

Rone Contd.

N. 40° - 40' E  
 + 41 = 21.83. N. 49° 20' W. 473  
 N. 40° 40' E. 7.39 to N. S. line. or  
 & cor witnessed by bearing trees.  
 Begin at the above corner  
 run S. 306 to a point from  
 which an ash. brs. West. 02

S. 65 <sup>1</sup> / <sub>2</sub> E.	4.77	cedar stake.
" 19' "	214	dir 12"
" 5' "	633	birch oak 8"
" 26' W.	222	" " 8"
" 71' E	324	ash 12"

75 further & center of creek  
 ash 12" for bearing tree. marked  
 S. B.T. old west side of creek.

Harry Haines

Jan 14 - 15<sup>th</sup> 1931.

Feb. 22 S. R. 5 W.

Begin at S.W. cor of cell 6  
both old trees gone. Found  
marks on N.E. log.

There seems to be a difference  
in the bearing and distance  
of the old trees. (rock corner)  
Run East from this corner  
Var. used. 26' seem to follow  
old blazed line 41.66. Intersected  
S. of 4 cor. 02. Set a fir post and  
re-marked both old trees. con  
stands on S. slope

North from 4 cor. steep asc.  
top of ridge, steep desc.

Bottom of canyon from here  
run line north 30' E. without  
chaining to North line. Intersected  
E. W. line. 26 W. exp. of long  
cor. moved stake N to W. S. line.  
Begin at 4 cor. on W. end

275

1270

Haines Coulee  
 side of arcton 6" stone in  
 marked a fir stump 32 S. 16  
 W. 17 Cch.  $1/2$  7.49° W. 26  
 Carb. farm cor. Nov. 20<sup>th</sup> 8  
 through trench and fir tree  
 bottom of canon steep ac.  
 top of rubble steep down along  
 N.E. slope.  
 stream c. NW, ac.  
 add stake for cor. on S.W. slope.

20.00

78.00

40.00

41.55

41.55

Survey for. Nov. 18th. 1930  
Meyers. & Medley.

Run line from cor. by fence South  
intersected cor. on South. 34. W. of cor. distance  
15.75 at 11.81 set stake East 25 $\frac{1}{2}$  at 7.87 set stake  
S. 17 at 3.94 set stake E. 05 $\frac{1}{2}$  on to cor. 15.71. etc.  
Stake set on true line

Cokeran  
from sec North 25.10  
or C. W. 40.26 and E. 4  
to cor. 08 cedar stake  
S. 17 tree gone marked  
at cor. wh. at 16.84 N. 16  
remarked W. base. S. 100  
S. 42 W. 17.83 to dam  
eight cedar stake marked  
sample 48745 E. 66

NO  
TSP RG Sec

Minnie Krewson.

Description.

Beginning at a point on the Township line North 88 degrees and 45 minutes West 1380.5 feet of the quarter section corner on the North side of section 4 being also a point on West side of County Road thence following Township line North 88 degrees and 45 minutes West 211 feet to an iron pipe 1/2 in diameter and 30 inches long thence North 33 degrees and 30 minutes East 131 feet to County Road thence, following along same Southeast-erly to place of beginning.

All lying in section 21 S R 5 W. Willamette Meridian, Douglas County, Oregon and containing 30/100 of a acre.



Index

Wm. Kelly 37  
 Perkins & Beube 38  
 W. G. Henderson 39-40  
 Whipple & Harlan 41-42  
 Benj. Watkins 43  
 R. W. Jarvis 44  
 J. B. Applegate 45

Index

Suttack & Smith Page  
 E. J. ... 2, 3  
 J. ... 4, 5  
 ... 6  
 ... 7, 8  
 ... 9  
 Leeper & Pileon 10  
 ... 11, 12, 13  
 J. A. ... 14  
 E. A. ... 15, 16, 17  
 J. J. Miller & Pheon 18  
 ... 19  
 W. J. ... 20, 21  
 Mary Perkins 22  
 ... 23  
 J. ... 24, 25, 26  
 J. J. Miller Esq. 27, 28, 29  
 ... 30  
 Pioneer Lumber Co. 31-2  
 Bent Selamney 33  
 E. R. Stevenson 34  
 O. L. ... 35  
 Martin Anderson 36

1889

Oct

26

Page

Medley

Chenoweth

Young 325. - 1.25 } 2.75

" 12 1/2 25. - 1.37 1/2

" 50 300

" 2 = 2

" 5 Young 100. - 30. } 70.

" 150.

" 8 O. & C. R. R. car hire

" Chenoweth Stearns 500. ( 5.00 }

" 250. - 100.

" O. & C. R. R.

" " "

" " " "

" " " "

" 18 Young 125. - 1.35. }

" 100. - 50

" Linnick

" Ch. H. Y

1888

1. Hammitt 30

5. Young 760. - 175

30. - 50, - 250

Oregonian

2. Chenoweth 15

" Young 2 1/2 2

" 50. - 100. - 100

" 50. - 50. - 21 50.

5. Young 1 1/2 1

8. Young rough

15. Young 800 - 8

" Hammitt 14.00

" Chenoweth 1.00

16. Young 8.50. - 25.

" 5. - 1.175, - 50

38 50 20

" Hammitt 25

" Chenoweth 4 6 = 10

" Young 1 = 1

19. Young 100 2 1/2 10

" Page 2 = 1/2

1889

5	Young 16½ to 22½	38.80
2	Young 26 to 25	3.00
4	F. Tipton s.	3.70
10	M. Tipton s.	6.50
19	M. Tipton s.	4.00
15	Young 17½ to 20	4.00
7	W. Wilson s.	5.25
30	Young 11½ to 27½	4.00
Nov 2	Rene s.	3.15
4	Loiss s.	6.00
8	Bryant s.	2.50
5	Young 1½ to 1½	2.50
18	" 5½ to 30	4.00
		1.65