

**OSCAR THIEL'S
FIELD BOOKS**

BOOK 5

INDEX
Oscar Thiel's Books

The following information was compiled June/July 1982. It is not necessarily indexed into the regular Surveyor Office files. USE AS YOU WILL

BOOK 5

<u>T-R-S</u>	<u>FOR</u>	<u>PG.</u>	<u>CONTAINS INFORMATION CONCERNING:</u>
T.23-4 Sec.28 & 33	R. Lambertson	1	1/4 Cor. 28 & 33
T.25-5	H. Hall & Davis	2	SW corner Green DLC #46
T. 23-5	Mrs. Jobe	3	Bl. 2 Wise Addn.
(unable to tell T & R)		4-5	1/4 Cor for ? (possible 17 & 18 of T.22-
T.22-4	Cutlack/Hardy	7	Same point as pages 4 & 5
?	Wells	8	?
T.23-5	Kruse	9	SW Cor. of DLC #40
T.25-5	Stearns	10	Stearns 2nd Addn. to South Oakland
?	Smith	11	
?	Thiel	12	
T.25-5 Sec. 4	Breidenstine	13	North 1/4 Cor. Sec. 4
T.25-5 Sec. 19	Worth	14	Description
T.25-5	Spencer	15	Masonic Assoc. Cemetery
T.22-7	Snellston Lbr.	16	Description
?	Turpin	17	1/4 Cor for Secs. 20 and 29
T.22-4 Sec 6	Yoncalla Lbr.	18	NW cor. of Sec. 6; SE Cor. Sec. 6
T.22-6	McCauley	20	description
?	Marsten	21	
T.22-4 Sec. 30	Fred Lee	23	NW cor. of Sec. 30
T.23-5	High School Dist	25	SE cor. Burt DLC
T.21-4		27	description ?
T.21-4	Lawrence	35	NW Cor. DLC Hall
T.21-4	H. Lee	37	1/4 Cor. Sec. 1
T.22-5 Secs. 4&9	Tinsdale	45	1/4 Cor. \$ 7 (; description



K. June

Apr 12	1/2	day
"	14	1
"	15	1
"	16	1
"	19	1
"	20	1
"	26	1
"	27	1
"	30	1/2
May 1	1/2	"
		<u>8 1/2</u> days

8 1/2 days @ \$1500 = 1260

17
<u>151</u>
26
176

Henry Hall's area
Feb 25th 1948
No. 25 S R 5-107

Begin at S.W. cor of nm
Greenwood S. N. 1/2 46. small
iron pipe by the side of an
old oak fence corner


Run North along wire line
574 ft. to 2" pipe 869.7 ft.
to highway Right of way
which is 14' x 16'

iron pipe thence East on S. side
of same 295.4 ft. which is
an iron pipe

Mrs. Jabe

Feb 22nd 1948
Block 2 N. use Addition

Begin at the corner in
Main St. East to iron rod
South from same point to
South line of original gone area
East to S.E. cor. South 50 ft. South
120 ft. to a point 30 ft. S & 120 S. of
S.E. cor of Lot 2 Bl. 2 at N.E. cor of
Lot 3 of an iron pipe 1/2 x 1/8 long.
come at S.E. cor

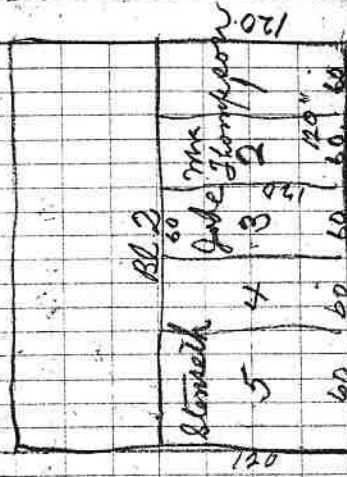

U.S. BANK NOTE CO. CHICAGO
Greenwood S. N. 1/2

Century & Star

71 26 26 47 19 47

S 87 1/4 cor 395

W 83 1/8 from 1/4 cor
W 80 1/8 to center of creek

400 S 23 1/2 W 589 chm

" 25 1/2 400 350 top

" 27 W 415

" 53 " 640 in open

step descent

S 53 W for stake 1.50

at the 1/4 cor set a

cedar post and drove a 3/4 in
pencil alongside and

marked a pier 10" S 52 1/2 W 179 ft

" " 8" W 53 1/2 E 18.2 "

Good bearing trees gone

From 1/4 cor. North 1248 to

edge of road S & E along road 100 ch

leave road S with east by to creek

from creek S 88 W 377 to 1/4 cor
June 8 2 hrs
8 1/2 "

Gas & Men

Feb 28 19 47

Surveying in Bl 2 to
next addition to
fundular 2 1/2 hrs

260
50
370
370
300
910
85
995

June 22 1880

Century & Star

From 1/4 cor South 3.95 chm North 80 1/2

E 6.65 to white pier 20 hrs in diam

From to run N. 80 E 4.00 to center of Cr

K 6 R

June 24 1880

N. P. BANK NOTE CO. PRINTING
St. Louis, Mo.

Frank & E. J. Sullivan
 Feb 27th 1947
 Tp 22 S R 5 W

Begin at 4 sec cor be-
 tween sec. 17 &

Pd \$11.00.

Berk Co. Utah - M.B. Hardy
 March 12th 1948
 Tp 22 S R 4 W

M.B. Hardy

Begin at point given Feb 26
 which is S 53 2/3 W 640 this point
 was changed to S 50° W.

cut oak 7 N 57 W 27 ft
 " 8 S 39 " 36 ft
 At a point N 50° E 640
 marked with oak. 20 N 10 W. 61 ft
 " " " 22 " 688 112 ft.

S 53 W. 16.78 ft of hill on N 100
 through bottom (near 54°)
 16.78 + 12.50 + 144 to north side of road
 curved square road 3/4 in red iron pipe x
 30 in dia. marked Maple 28" N 50 E 58
 oak 12" S 15° E. 66 1/2 chms.
 S 65 1/2 W 378, N 80 W. 328 to Co road

11" BANK NOTE CO. TACOMA
 "Return the favor"

Pd

\$25.00
 Pd 3/20 \$38.00
 3/20/48

10

Ruth & Smith

A. F. Stearns

May 23rd 1948

March 24th "

Began at an iron road 1/2

inch being S.W. cor. of Street.

Stearns 2nd addition to

South Oakland.

4 hrs.
5
9 hrs. \$16.00
7 hrs.
Paid 75
\$20.75

Total \$3.75

\$24.60
Apr 24 1600
17 hrs. + \$0.30

Apr 24th 48

Beg at S.E. cor. of Road
S 85° 10' W 20 ft. S 61° 25' E
100 ft. N 73° 5' 10" E 30 ft.

\$46.00
\$31.00

6/28/48 ck \$45.00
\$14.65

2 1/2
1948 7/5 4/98
June 7 1/2 hrs
June 10-5307 hrs
E v W
12.7.13

5th M Fullbright

Apr 29th 1948

Began at 1/6 cor. stake a cor. of

James market 20' N. 51° W of A
" July 22 S 77° E 34.5

S 89° 43' W
5 rods by rise of gradual
dip at 20.06 ft. paper
along N slope.

5/4 Began at ending of lead

survey N. 55° old blazed at. in
approx. N. S line trend &
old cor. of Bowman, land
run west 400' paper 60.00 at a
rate 1957 paper
60.00

Paid by 4 tier undivided 20' \$3.25
June 8/18 \$20.00
\$16.75

5/14 " \$16.00
Fullbright
Bal due 1948

12

May 21. 1948

25.05
9.1
24.14

From T6 cor on C line

589° 30 E
24.14

S 12° E 5.00 ch 14 1/2 feet

N 92° 10 W 1/4 x 30 with cypressing

9.00 pipes

Marked forked a H. ok

35.12
9.20
25.92

1 1/4" N 57 E 57 inches

10.87
9.91
9.96

Line S 89° E 23.00 x 22 1/2

9.85
5.26
4.65

A 1/6 cor on W line 3/4 in x 24 pipes by fence top & from which for 20" S 15° W 21 lbs. with cork 9 S 50° E 12.3 ft. for 20" S 75° or 80 E 10.2" (old tree)

S 12° E from T6 cor. 5.20 to an 1 1/2 ch x 30 in pipe with cypressing on top dorm wh. a H. oak 14 in in diam. W. N. 57° E 4.2 ft. marked 30.00

40 89.60
31.30
58.30

Apr 17th 1948

Bridgewater 13

Begin at 7 o'clock cor on North side of Beck 4 J. P. 25 S P. 5 W. Montreal

5.57 W

Blum 1760

Rem East 4.63 ch (3055) ft & cor.

John H. Bennett 21 ch (14 1/2 ft) 3/4 iron gal pipe x 24 each 16.5.6

89.4
5.52 W
31.30

1/2" steel rod 24" long

a locust tree 6 in diam

W. N. 42° W 50 inches

S 12 3/4 W. along road 26.1.3 ft

1/2 diam rod S 26 W. 11.4.6 ft

iron rod in rock 7° 55' W 5.46 ch (3003 ft) & beg. cor. cont

chg \$ 11.75

N. Y. STATE COLLEGE
GEOL. DEPT.
ITHACA, N. Y.

14

Sidney H. March
 7th St Sutherland
 Apr. 22nd 1948

Beginning 162 ft North
 27 West from 120 ft
 S. 88° 20' N. of the N. W.
 corner of lot. Subman
 S. 28° 20' W. 137 in Sec. 19
 Sp. 25 & P. 5th. Thence

running
 S. 27° E 458 ft
 " 88°-20' W 120 "
 N. 27° W 458 "
 " 88° 20' E 120 "
 Cont. 1.26 acs

Deed description
 Bag 144 ft S. 88° 20' W of N. E. cor
 of Sec. 2 Holman S. 28° 20' W 37 sec.
 T. 19 Sp. 25 & P. 5th. from 77d
 S. 37° E. 441.5 ft. S. 88° 20' W east
 60 ft. N. 37° W. 441.5 ft. N. 88° 20' E
 60 ft corner Cont. 61 acre
 Surv. \$6.00
 2 acs \$140.00
 \$146.00

Bx 88 George A. Spencer
 May 8th 1947

Begin of a large stone 7x10 15 ft
 opening
 being S. E. cor of Masonic Ave.
 88° 20' 106 ft
 station to military x road. 161

Chas. S. 3° E 197.5 ft. Begon white
 stone S. 3° E. 197.5 ft (191 ft) 88° cor

on S line has S 88° 20' W 106
 197.5
 191.
 2088.5
 6679.47 (570)
 198
 191.
 7.83

Deed desc. S. E. cor of Masonic cemetery
 (stone) S. 3° E 5.15 ft. N. 88° 20' W
 5.15. S. 88° 20' W 161 ft. over back 4
 \$14.00

9 B B X 88
 \$14.00

16 Dick

Begun at
May 22 48

Begun on N. side of
Highway N 81 E

John M. Phillips
4-5061
Greenville

00 BX 4449

N. side of Highway N 57 W
16.00 + 16 ft. from center

72 W 40 ft to pipe
128.4 from instrument

N 22 1/2 E 9.00 + 36 ft
1 x 30 pipe

N. 67 1/2 W 12.00 = 49 ft
from pipe on W side
of old road 5.90 ft
from slope from old post
on hill 12.00 + 57 ft to
right of way

N 57 W 13.60
above
67 ft

5/25 PD \$10.00
5 hrs

Bruce Turyam
May 21 1948

4 cor box 20 + 29 red
pipe 1/4 x 30 marked maple
12 S 78 W 13.7
24 N 35 W 13.2 ft

5.00 S. onch ace 2 in 21°
4 in 12 7/4 58 5 ft 5 in
1. 14 " 37 W 18"
N 89 1/2 W deep dig not
measure this line

18

Generally Sbr. Co

May 26 & 27 1948

70. 22 S R. 4 N.

Began at NW cor. of sec.

6 old bearing trees
fallen 2 yr. post set

by survey for S.S. Thomas.

8-1912 (cor. of wire fence)

Run South Var 21°.

20.00 set Camp post on
West slope. 400 no
trace of old cor. cor.
stems on steep W. slope

Began at SE cor. of sec 6
set five post S 88° S E. trees
stand they marked a 30 N. E.

Var 21° Run line 20' did not
Chain - did not go to sec. cor.
2da. \$32.00

19

Mr Banks

June 1st 48

Leveling for pond 1 1/2 hr. \$3.00

July 27 - 48

Leveling at pond 1 hr. \$2.00

July 31st

Leveling 2 hrs. \$4.00

Aug 19th

Leveling for pond 2 1/2 hr. \$5.00

\$14.00

MADE IN U.S.A.
WATER RESISTANT

20 S. D. McLaughlin
 June 3rd 1948
 Twp. 22 S R 6 W

Began at a point that
 bears South 3.68 chains of
 the NE cor. of S & E 1/4 of N. 8. 7
 Thence N. 23 1/4 E. 570.20 feet
 thence running North 23 1/4
 East 235 ft to a 3/4 x 30 pipe
 on N. west side of Co road
 thence South 57 3/4 West 90.42
 ft to an iron pipe thence South
 37 1/4 West 105 ft to a 3/4 x 30
 inch pipe for 10 S. 20 W
 S 3 1/2 W 269 ft

6/11
 20.00
 22.00

Miss Faye Navsten 21
 along N. side of Highway 865
 June 17th 48

feet S. 67 1/2 W. to fence post and
 pipe 3 x 24. 19 1/2 x 3 ft each 23.8"
 to begin
 South N. W. cor South 133.5
 to line fence. West along
 wire fence 122 ft to pipe

3 hrs.
 6/21
 2 d. 50.
 \$10.00

THE BANK NOTE CO. INCORPORATED
 125 W. 4th St. St. Paul, Minn.

200 Land 1st June 1984
 22 SR SW
 Retracing line of
 former survey
 8 to 12, 4 hrs

06
 14.0
 5.1.2

OK PD 8.00
 8/9/48

66 42.3 7 rd. 9 el 109.3 23
 1093 June 26 47.8 4.438
 148.4 57.4
 57.4 W Cr 1 Aug 30
 22 SR SW
 Stone 6x7 x 16 cross by June
 rock N. W tree N. 52 x W. 33 =
 M. c. 10 x 15 W 27 N 4.43.2
 E side of Co road
 W. 12 x 13 on way C. to W. 200
 of Cr. 10 57.4 N 100 W 52.4
 1/2 way N. 15.00 + 35' N to bank
 of creek 25 or 30 ft + 20 ft
 creek 3 ft x 24 ft deep bank 17 ft
 1700 ft ash 30
 700 N. 20 ft x 20 ft
 50 ft x 4.00 E 2 ft x 28 ft
 6 in. 100 ft W. center of bridge
 Center of Cr. 7 ft from center of bridge
 6.22 N 800 + 50 ft N 46 W. Bank 10
 74.5 W 4 10 ft N 3.600
 N 34.5 W 5 42 ft N 44.5 W
 4 100 ft N 90 W. 100 ft
 (24) 2 1/2 hours. 100 ft SW.

24. Eagle Grove
 Yoncallo Cemetery
 July 8 & 9

8th 1 hr. 2.50
 9 3 hrs. 7.50
 Not Rd. 10.00

At 2 Lot 22 Bl 4
 Found the original
 stake for S.W. cor of 22
 also S.E. & N.E. cor
 and S.E. cor of Lot 21

10.00

High School Dist 24
 July 14th 1948
 Jp. 123 & R 50

Begin at S.E. corner of
 Blk 10 S.E. remark the
 old tree drops to iron
 road in Road Run creek
 on section line 22 1/2 Chas
 to West side of 24 highway
 Right of way of 24 highway
 looks East from S.E. cor of old
 cemetery. ^{4.24 + 4.57}

7/16 S E along highway
 10.20 Chas 2.23 Bl + 70 ft mark
 from beg. 3rd highway W
 10. del line 17.6 ft to stake W
 side of highway
 Line in 52 ft to S side of stake 40 ft
 June 8 91 11.00. & 7/11/48 2. Chas
 Cal. 7 ft

Soth. from NW cor of Blk 10
 road at upper NW 8 ft offset W

1/8 level per school \$50 avg leveling 80
 1 hr \$2

MADE WITH THE "LACONA"
 "Return to the Future"

26 School Dist

July 16th
28 ft official book 17.9 ft

19th From SW cor East
to N-S fence
15.50

18.1 ft NW Begins on d line
1.00 S. 1473 Inter. N of E. W

28. Line 18.3 ft East to Right W
1.8 fence 1. ch. 27.2 ft

18.1 ft NW Begins on d line
1.00 S. 1473 Inter. N of E. W

10 + 42 ft SW. cut. 29 ft to N-S
along highway fence

July
On N. side of highway
from cl. line N 40 40' NW

29A 10 ft NW line
S 2.50 ft NW

On W side of 602 ft + 10 ft
N from SE cor 30 2.2 47 15
9985 N 30 8 20 45
370. 4.40 W 370

27 Stephens

July 15th 1948
Sp. P. 4 ft

Pipe 3 2 3/4 on E. side of Leo Rd
N 80 8 12 6 ft to
S 80 W 2 6 1/2 ft to road fence

at SW cor marked a few 29
S 73 3/4 W 55 ft

Old survey pt in center of
COR 13.15 ft

110 ft N 36 1/2 W 264 ft N 408
17 ft

33 ft
3 ch 7 1/2 ft

16 1/2
20 5/2
9 5/2

N. P. BANK NOTE CO., TACOMA
W. P. Stephens

Ad. 1-20-49 \$16.00

28

Fried Dec
July 17th 1948

Begin at ore cor (stone)

Run S out var 21 1/2°
dec. 480 to stream 3 in
c n. & acc. step 10.50 line
spring S 40 ft. 20.18 chm.
alted to apt 18 x 1' marker
for 24' N. 7° 15' E. 32.8' ft.

Same way Run 210.
S 89 1/2° E step dec. 12.69
to wire fence alid chap
78 to 1 x bearing
that survey

on ord. line

8	44' E	85.00	chm	feet
"	42' "	4.00		422.0
"	16 1/2' N	6.00		48.0

Lead survey

N 3 3/4 W 63' 4 ft

page paper N 18 1/2 W 500 - 36 ft

1 1/4 25' paper N 75 E 20 A cement

Fried Dec 29

at mid maple 10 88 18 mo

S 67 1/2 E 400 ch
48 1/4 500 A Rd inter-
section N. 62 E to bridge
did not remember
from this part N & fence about
130 ft July 22 2 1/2 hrs

46.00
48.50
20
8.50
8.50
2.00

bal due

2 dump 32.
2 1/2 5.
37

2 dec 4.00

shaded col 2.00

3.00

9.00

37.00

28.50

46.00

17.50

50 cedars park

35

2 days

2 1/2 hrs

32.00

5.00

47.50

due in 47.50

3b

Horrorville
July 29th 1948

Township 30 S R 5 W

Began at an iron pipe
on West side of Co Rd

138
276
8 1/2
P

1 day
Bus fare

10.00
76
3.00
17.76

Bills
July 30th 1948

Exp. 21 S R 3 W (at cost)
from 1/4 sec 36 ft large area
offed 72 inches North 450

Top of ridge level 700 level

opening 8.50 peg - 40.65

Beg in wire fence corner pipe

S 22° W from pipe 10.40
66

marked belt 24 S 66 W 40.50
R W ready 4/16 50

Beg in at a 1 1/2 inch iron pipe
a hole 20 S 75 E 142 ft

S from 1/2 m pipe S(3) W 330 +
20 - 350 to 1000 1' x 2 1/4

S 79° S W (4/10) 80 ch x 39 ft
to 1" x 2 1/4 stone S 22° W 27.4 ft

FROM pipe N 20 E 27.4 ft
16.00
40
2.8
85 Sunday 8.22.40

W.P. BANK NOTE CO. - DENVER

July 3rd windmill post
 66
 53.9
 7p 21' 8" R 3' W sec 749.9
 Beg cut & cov of lead

No 2 to 33 W 60 ft to
 wire fence

Begin stake S 18° W 4m
 back N. show 19 3/4 S.W.
 cor. 119.9 ft.

across South line N. 74° W
 S 74° E
 all led marked

put 18 9 1/2 7 5/2 E 14.8 ft
 & 7 3/2 E from peg 20 ft
 South W. cor

S 73 1/2 E 7 ch 51.5 ft on
 b. line

PA & E cut needle show S 74 1/2 E
 line N 33 1/4 E

S 73° 1' E
 correct

Chyge-Sun \$8.00
 Abac \$12.00

Glen Lee 33
 July 21st 1948

Search from NE cor on
 hill top to N side of R of W
 of road highway S 21° W

Work on N line 208.7 + 52.2
~~260.9 ft~~ 260.9 ft known

page 21 ft by 24 along wire fence
 S 1 1/4 W 21' S.W. cor

Cont. about 5.60.5 ft to

highway fence N 64° E 4 ch
 22 1/2 ft to fence post

E. T. Board.
 \$186.00
 \$12.00

N. B. BANK NOTE CO., STAMPA
 12-2-48

34
290

5.00
30
41.70

M.B. Clark
Aug 4th 1948

5.00
2.66
7.66

Began 1st wire fence

Ran wire along fence

Wire fence 470 + 290

East side of Leo Road

W. 470 + 33 = 4.03

S 2.00


N. 24¹/₂ 2.00 + 13¹/₄ to cor

lying SE 1/4 of NE 1/4
S 1/2 of NE 1/4 of sec 4

SE cor

2.90

2.50
2.45
2.21
4.90

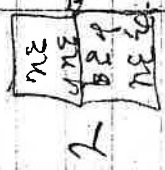

Sp. 21 SR 4 W

110.00

P. 21-4

Aug 7th 1948

Spencer 35

Began at cor. of Hall & E.E.
M.W. cor. trees cut down
No. 37. Both old bearing trees

Goed & E. tree cedar stumps and
stump of N.E. tree from old state
set line & moved N.W. corner. This is
same cor. Palm Road & Palm cor.

Head cleared along fence 15.12 +
fence back set with base 34 x 30 on East
side of roadway. Thence 24 p.m. 2
long to side of road

to paper 3/4 x 30

B 45°W 65.6 ft N 45°W 10 ft

1. 26 1/2 E 147 ft 45°E 10 1/2 ft

line 26 1/2 ft highway R.W.

1 x 24" cedar 160 ft along N.W.

170 ft N 47 1/2° E 119 ft 1 x 24"

N. 40 1/4° E & of line 160 ft 1 x 24"

to cor. on E. line from of W

470 7.3 ft dip 1 x 24" N 57

100 ft 46 ft N 86 ft

W. PAINE NOTES CO., YACONNA

6 hrs

\$12.00
\$1.50
\$1.50

36 ^{near} ~~near~~ ^{North} ~~North~~ ^{Drain} ~~Drain~~
 Course ^{North} ~~North~~ ^{Drain} ~~Drain~~
 & line ^{Recovery} ~~Recovery ⁱⁿ ~~in~~ ^{crosses} ~~crosses~~ ^{Ad-} ~~Ad-
 524° N~~~~

Term
 plat
 4 1/2 hrs
 \$ 9.00
 \$ 4.00
 \$ 13.00

A.M. 27

Aug 1st 1948
 21 & R. 21
 In oak ~~one~~
 Begin at stone corner
 a hole # 4 sec. corner
 North 7.00 1/2 x 24" iron tape
 in center of ~~to~~ road a hole
 three East 2.8 stream 316 S
 19.2 to north x 24 iron tape
 three North 3.62 East
 7.07 North 9.96 to East fence

S.W. 1/4 of Sec One
 2018
 13.12
 7.06
 7.06
 10.02
 9.56
 10.62
 9.82
 2.00
 10.62
 20.40
 9.82

at 76 cor. on S.H. Lee Sch
 meeting with Mr. & Mrs. 29

9 hrs.

W. F. BARNES CO. - ALBANY
 12-26-48

38
10-300
L. Bennett
Aug 18 48
" 19

Begin at a stone x
S. E. corner
along R. of A.
10' E 106' N
75' E 117' N
N. 101' W 368' N
S. 192' W 121.4' N

2nd
E. 101' W 160' N
N. 252' W 279' N

along highway
N 78' W 150'
" 70' W 50' N
N 195' E 76' N
" 190' E 75' N
E. 159' N 1' W
N. 18' E
* line
S. 49' W 78.00'
4' 87'
4' 87'

1848
2.25
2.93
2.458
2.29

159
78
3
2
76
82
2.1157

229
50
1503
48
12053
68

1602
25
1852

1570
159
213.09
1524
114
154
152
175.36

1570
159
213.09
1524
114
154
152
175.36

159
78
3
2
76
82
2.1157

300
178
3.00
18
2.82
2.82

Aug 18-19

1570
159
213.09
1524
114
154
152
175.36

1602
25
1852

1570
159
213.09
1524
114
154
152
175.36

1570
159
213.09
1524
114
154
152
175.36

159
78
3
2
76
82
2.1157

40 Murb
Aug 20 ch 48

Begin on South side
of Highway

North 400 M 412
East 134 ft East 66 ft
Form Reg beam East
336 ft to West end of

Creek
July 21st

Begin at an iron pipe
2" x 36 along fence North
from Cox. 1360 ft North side
of center line on Highway
Thence East 56 ft to property
line E. W fence line
1 1/2 x 24 for beginning

20.00
13.20
3.60
19.60
2 ho
8 to 11 = 3 1/2
\$12.00

Glenn Wells 44
Sept 18th 1948

Begin on Highway near
road on 5 1/2 M
measured 880 ft. 25 ft center
of Street 34 x 24" iron pipe
S 29° E 260 ft pin stake S 9
W 126.5 ft pin stake. S 70° E

Wells Wilson 1/14/49 trip to Reed
tung core sent to Smithsonian + 6 1/2 hrs 8.00
11.00 description for map \$6.00

Sept 29th 48 Trip to Oakland
set pipe for struts and Sutherland 1 day 8.00
Ladies from Oakland came after me
\$12.50

June 5 hrs
\$12.00

42

J. L. Medbee

Sept 22 1948

Begin at the N.W. cor
of claim 72 46 and
S.W. cor of S. L. 8 47

E. L. Wilson 43
Dec 5th 1948

Begin at 4 sec cor a corner
5' and 1/2 in center

§ 11 1/2 E 348 ft iron pipe
§ 82 1/2° N. 61.3 ft to belt line +
144.6 ft to cor. of pole. N. 29° W
3.00 ft to a point in roadway
thence N 44° 45' E 17 ft to an
iron rod 67 ft pole and cor
then pole 335 ft from corner back
to an iron pipe on belt line
then South 116° 30' East 178.2 ft
25/100 of an acre in sect 3
and 2.08 acres ±

W. B. BARN NOTE CO. TACOMA
Printed in the U.S.A.

2/13/00

44 Blumy
Gonzales
Oct 8th
1948

Agon
Abr. Co
1948

Went to N.E. corner
and 6 old stakes

Ran East 2000 to
new stakes and cor-
ner of wire fence

East 2000 no trace of
old fence. Cor. marker

2000 old six stake
Went for 10 rods to

top of ridge.

Paid 11/26 \$2.00
11/11 2 1/2 for leveling.

\$22.00
\$17.00
5.00

Bierford
Jung
Oct 13th 1948

Jung
Oct 13th 1948

Begin at an old stake east
for the 4 sec cor. by 4-9 Jp

22 to P 5W. Went from cor
descend. 110 ft of descent

900 ft in road way South 500 ft

Went 384 ft South 54 ft West

200 + 40 ft North of Highway 99

thence South 38 ft to yellow

lime from yellow lime 60 ft to

a point 20 ft North of center of

railroad track thence along
Highway Road SW 605.3 ft South

349 E. 48 ft to R. fence
PI \$13.00

To Rowling

Mar, 25-26. April 5th run line
at road to Hillb line fence
H car worn paper 30 x 1/2
buy atk gunc paper

at the 76 car at pk of hill

1 x 30" paper along side of
fence

marked for 16 N. 41 1/2

June
4/5
8 hrs. W 25.8 pk
from 76 car N 11.22. pk
of hills.

2.14
66

12.84
12.82

140.24 ft

Wagon City \$29

- 26-25. High level Asst 709
- 27 Roy Stephens
- 28.29 Fred Lee
- 30 J. J. Reed
- 31 Bill Reed
- 32 J. J. Reed
- 33 J. J. Reed
- 37. M. J. Lee
- 40. M. J. Lee
- 41. M. J. Lee
- 38.39. J. J. Reed
- 36. J. J. Reed
- 42. J. J. Reed
- 43. J. J. Reed
- 44. J. J. Reed
- 45. J. J. Reed
- 34. J. J. Reed

Page INDEX

- 1 John Ray S. Lamberton
- 2 Henry Hall + d'arv
- 3 Mrk Jobe
- 4-7 Co. Willock + B. Hardy
- 5 J. A. Jones
- 6 Frank + E. Hewell
- 8-11 Glenn Wells
- 9 Mrs. J. J. Kowal
- 10 A. F. Kearns
- 13 Geo. Briedenstone
- 14 Sidney St. North
- 12 H. V. Thiel
- 13 Geo. Briedenstone
- 15 Geo. S. Spencer
- 16 Richard G. Duncan
- 17 Bruce J. up p...
- 18 Genevieve L. B. Co.
- 19 Mrs. S. B. Cantley
- 20 S. S. McCaulley
- 21 J. M. Jullbright
- 24 Faye Marks
- 22 Mrs. Law
- 28-23 J. W. Lee

William W. Edmon (Surrey)

E. S. Woodford
P.O. Box 454 Rt 2
Edinboro

Richard Ecker Surrey
Mill St. gone away

Ernest O. Kabler
Attorney
Sutherland

Richard J. Thwing
Attorney
B-59

Bert Delaney (Broom)
F.H. Bryant P.O. Box 311

1574 Cutlack

Ralph P. Harro
9645 NE Main

Portland 13 923 16 1/2
W. E. Hardy State Valley

Percy Armstrong Eng.

Percy Armstrong (Phone 817RX)
118 ~~118~~ Robert St.

132 PM
Sutherland