


N 58° W	4.00	tho Center of the Road	to	to
N 65° W	11.50	to	to	to
S 56° W	7.00	to 5 <sup>th</sup> M post	to	to
	<u>40.00</u>	to	to	to
N 60° W	12.50	tho Survey Station	to	to
N 40° W	10.00	to	to	to
N 45° W	12.00	to left Bank of Totodi Creek	to	to
N 45° W	9.50	to	to	to
N 45° W	13.00	to	to	to
N 50° W	15.00	to 6 <sup>th</sup> M post	to	to
	<u>40.00</u>	to	to	to
N 60° W	2.50	tho	to	to
N 65° W	10.50	to	to	to
N 65° W	21.50	to	to	to
	<u>34.50</u>	to	to	to

I hereby certify that the above is an exact copy of the field notes of the Survey  
 This the 30 day of April 1873

Wm F Briggs

North

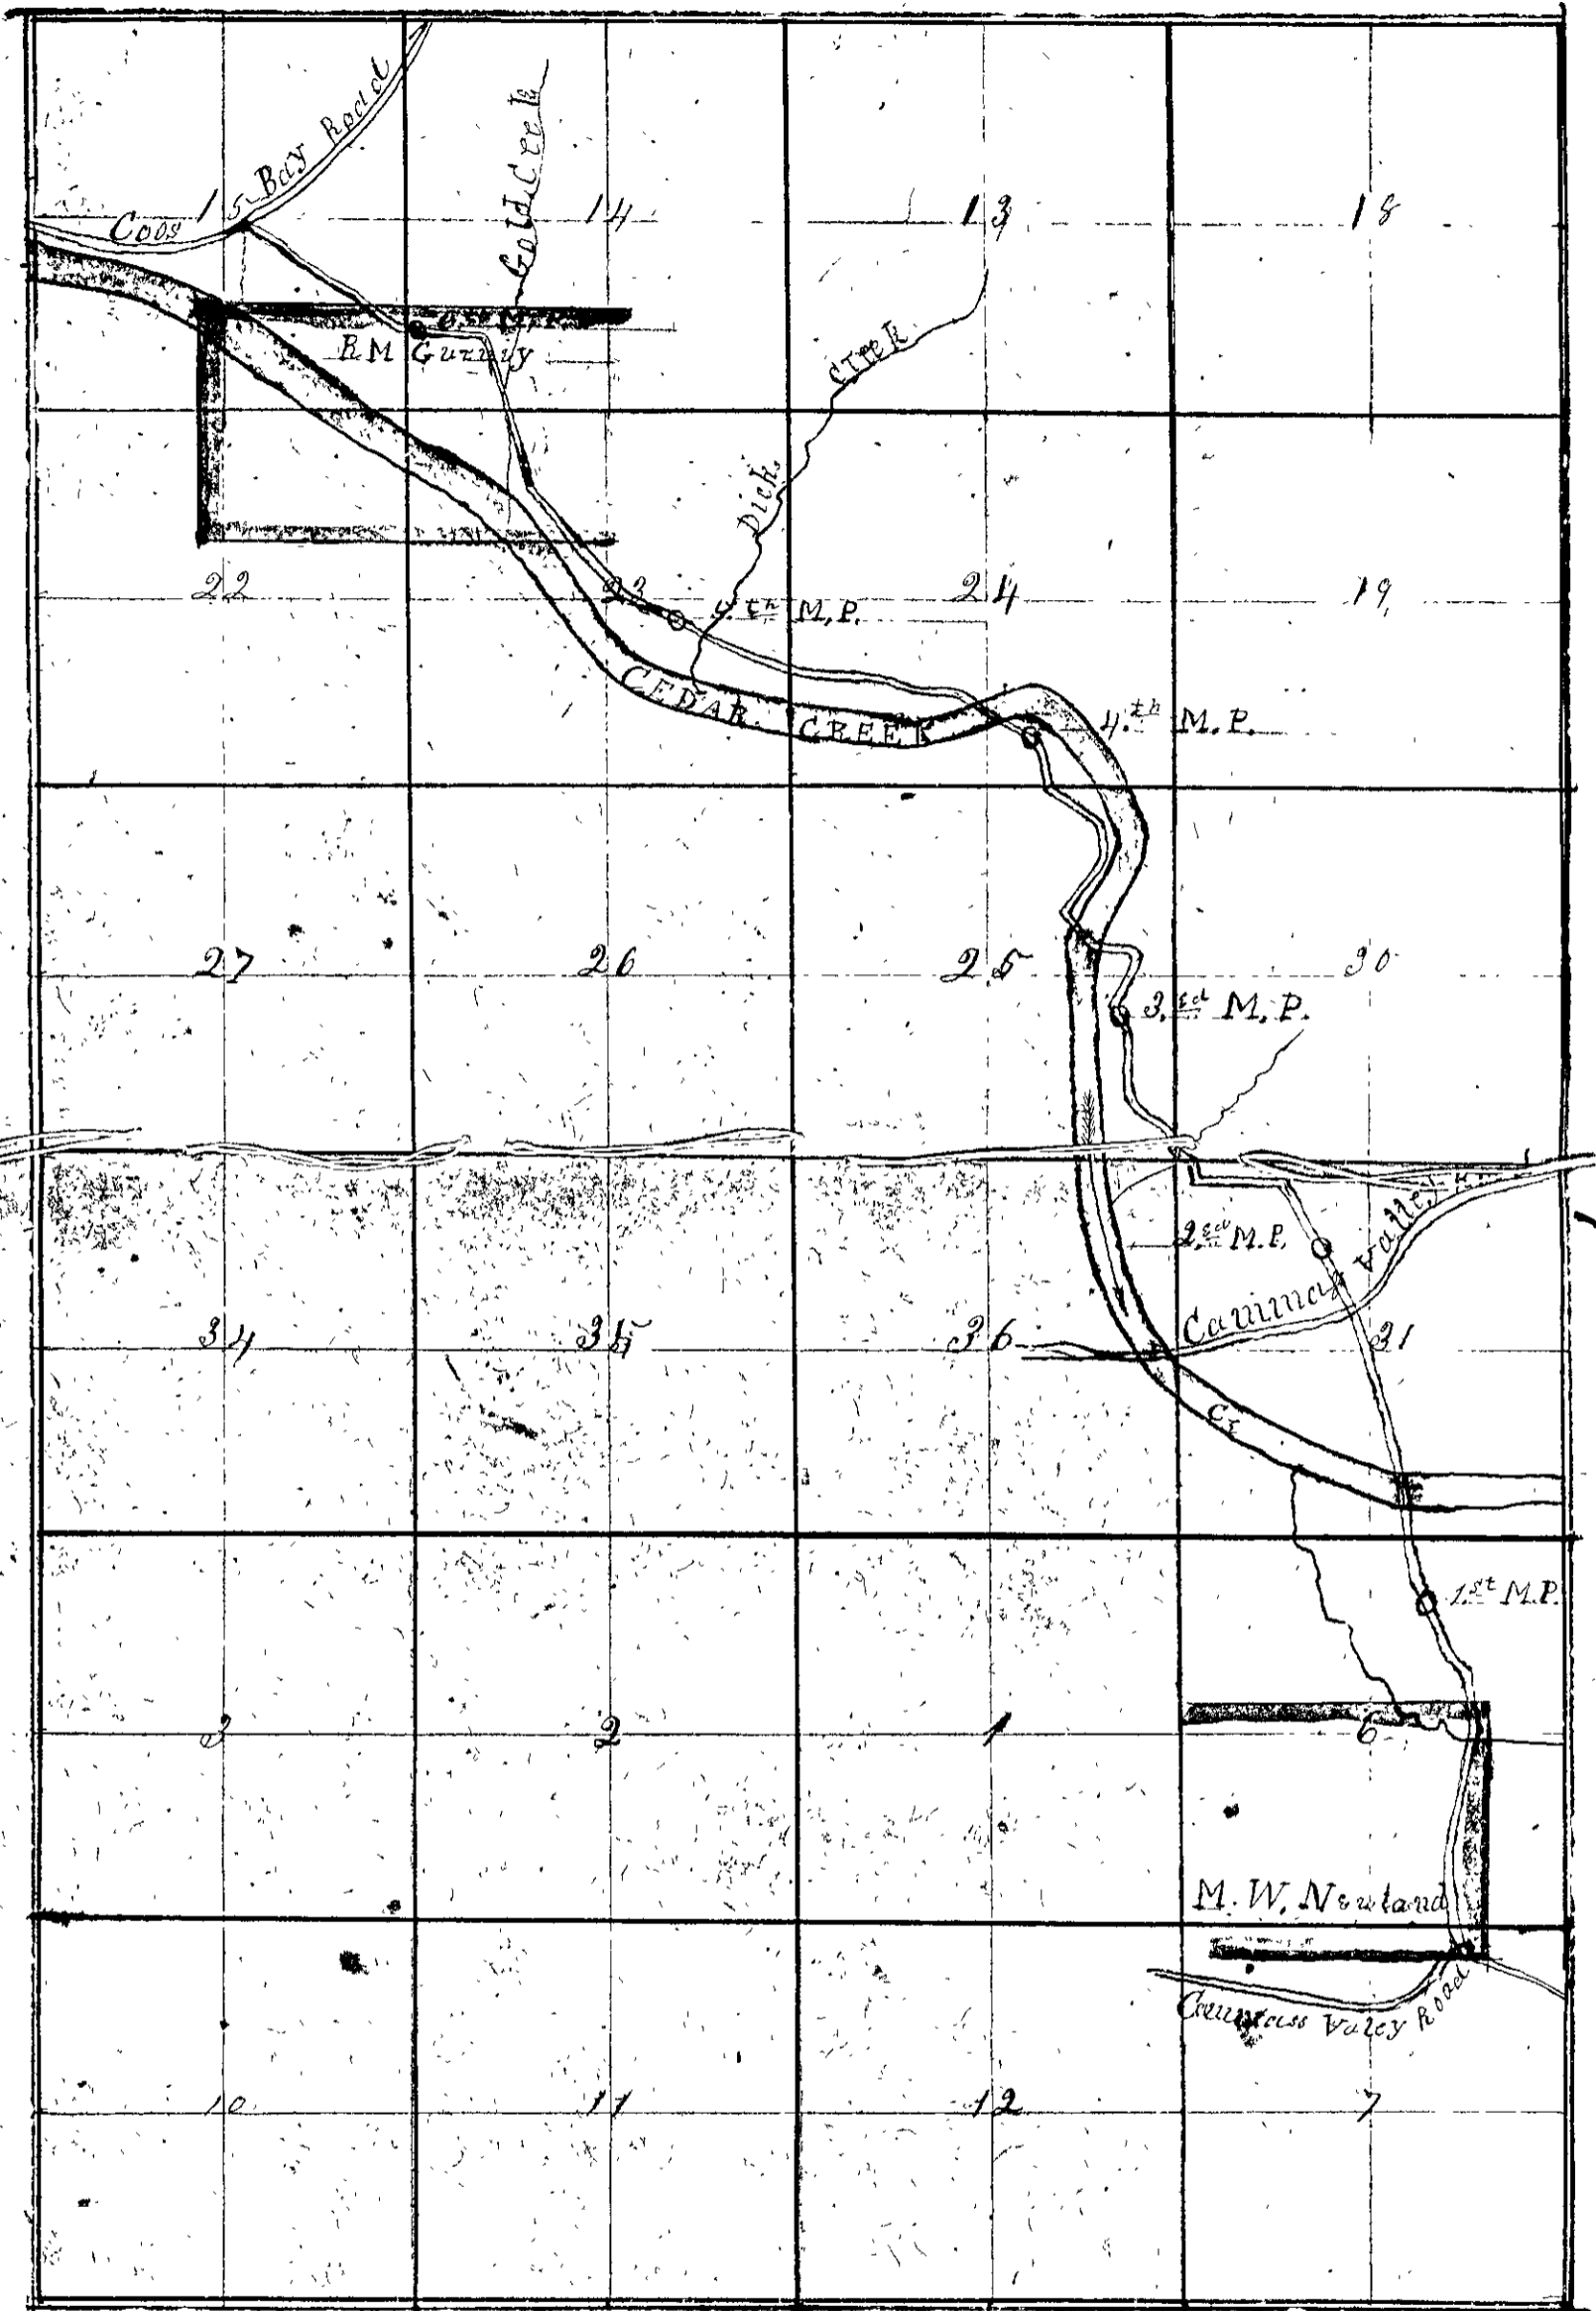

Scale of 2 inches to the mile

Handwritten notes and scribbles at the bottom of the page, including numbers like 10, 11, 12, 13, 14, 15, 16, 17, 18, 19, 20, 21, 22, 23, 24, 25, 26, 27, 28, 29, 30, 31.