

Survey No. 1

Made for... J. F. Chadwick

Aug 7th 1895

Beginning at 1/4 S. corner between sections 32 & 33
T. 25 S. R. 5 W. M. M. Crozer
J. P. Hughes & A. C. Strange, sworn chainmen
Over 19°30' E.

Thence N 89°50' W: 40.10 ch set temporary post.
Thence from the S. W. corner of R. E. Stratton Donation
Land claim No 38. The original witness trees remaining
I measured and run a line S 89°40' E. 49.40 ch
that being the distance called for to reach the S. E. corner
of cl 38. The original witness trees for this corner
has been destroyed.


I then went back to the S. W. corner of cl 38. Measured
and run a line North 10.50 ch set post.

Thence West 2.30 ch. Marked a Fir tree 6 in dia.
N. S. from which, a Laurel 10 in dia bears N 30° E 14
links dist. This being the starting point of the
tract of land sold by John C Smith to J. F. Chadwick.
Thence North 19.40 ch set post - from which
a Fir 5 in dia bears S. 25 1/4° E. 325 links dist.

Thence East 33.25 ch set post - from which
an Apple tree 6 in dia bears S 85° E. 231 links dist

Thence South 6.50 ch to post in field.

Thence East 17.50 ch to post in prairie. Thence
South 12.90 ch to post in field. Thence East 7.86 links
to post - from which chimney of Chadwick's house
bears S 68° E. and stove pipe of Cooper's house bears S 12 1/2° W.

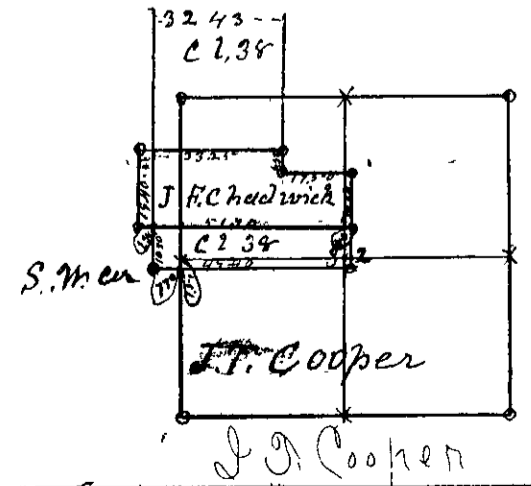

W. J. Briggs
Co. Sec