


Survey No. 16

Made for Douglas County

Sept 21st 1893 County Road. Beginning at a Post marked "R" from which the S.W. cor of Block No 15 of the town of Yoncolla bears N 85° 20' E. 30 feet
 Var 19 1/2° E.
 Thence South 15.00 ch Interest county road leading to Oakland Ar. Set post marked "R" from which the N.W. corner of A. J. Ambrose Donation cl no 41 bears S 42° E. 28 links. - set post East 34 links of the post
 W. J. Briggs
 Co Sur

Survey No 17 C. O. White
 Oct 12 1893 W. J. Hoyle & S. H. Cook Surveyors
 T. 29 S R. 5 W.
 Beginning at cor to Secs 17, 18, 19 & 20, T 29 S R 5 W. N.W. Cor
 Var 20° E.
 Thence South 20.00 ch made Stone Monument - Var 21° E.
 Thence East 40.00 ch " " " "
 Thence South 20.00 ch made " " " Var 21° 30' E.
 Thence West 30.00 ch to Willow bush on Right-bank of S branch
 Thence from Stone monument before mentioned 20.00 S of base
 West 30.00 ch to Right bank of S Umpqua river
 W

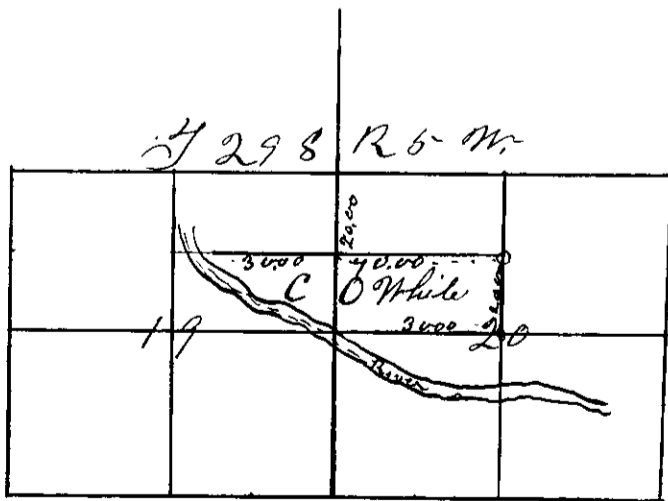

W. J. Briggs
 Co Sur