


County Surveyor's Record, Douglas County, Oregon

Survey No. 13

Made for J. Perini

FB 113 Pg 13-14

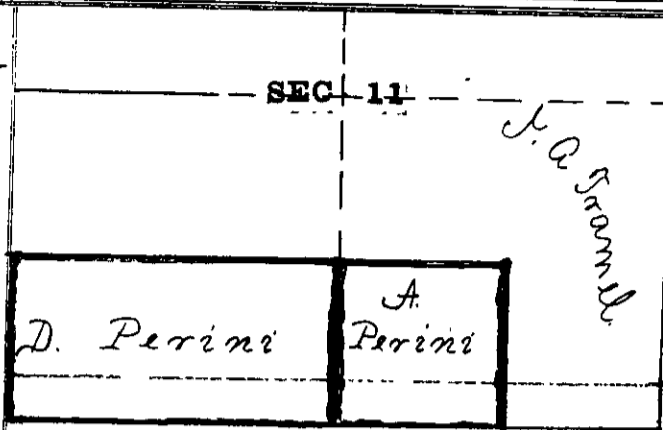

Township 21 South  
Range 4 West.

April 13-14-99

Begin at the cor to secs. 10, 11, 14, & 15 T<sub>21</sub> S R 4 W. set iron post and run S. 89° 34' E. at 39.82 1/4 sec intersect S of cor. Var. 20° 20' E. East from 1/4 cor. at 19.81 set post, a wh oak 20 ins bro. N. 85° W. 72 lbs. North from 1/16 cor. descend 14.00 railroad fence 14.45 centre of R.R. track, 14.95 centre of County road course E. & W. at 20.00 set post. (Var. 20° 10' E).  
Begin at 1/4 sec cor bet. 11 & 14, run North descend hill 19.60 Pass Creek course N. 20.00 set a cedar post.  
Begin at S.W. cor of sec 11 and run North. 4.65 Pass creek 6.00 centre of wagon road, 7.90 centre of R.R. track 20.00 set post near an old stake made by a previous survey. East from 1/16 cor. 29.50 centre of R.R. track 39.55 intersect 11 lbs N. of 1/16 cor. at 60.03 intersect 6 lbs N. of 1/16 cor.

April 18 to 22 '99

SURVEY No. 14

FB 113 Pg 15-20

Douglas County

Locating County Road from Scottsburg to Loon Lake. I met with J. A. Sawyer, Wm Burchard and Fred Weatherly, viewers appointed at the regular March term of County Court in the town of Scottsburg, as per order of the Court, and employed E. P. Upton and J. E. Parker as chammens and H. Laird as marker. Commencing at Smelling St., crossing Umpqua River and running in southerly direction and terminating in upper Loon Lake bottom. Petioned by H. Weatherly and 15 signers. Fieldnotes and plat of the survey filed with County Clerk.