


Survey No. 29.

Made for...

J. A. Tramel

FR 113 PG 33-35

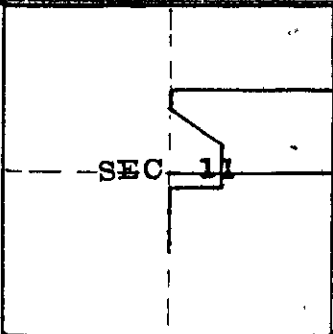


Township 21 South
Range 4 West.

J. A. Tramel

Oct 11, 1899.

Begin at the 1/4 sec cor bet secs 11 & 12 Twp 24 S R. 4 W. Var. 2 1/2° E. North on sec line at 40.20 intersect W of sec cor. at 20.10 S of sec cor. set a stone 16x10x6 per cor. from which a cedar 7 ins diam brs S. 5° E 17 lks. thence West 17.15 spring branch course S. 35.00 leave large timber enter opening. 39.77 set a cedar post. from which an alder 12 ins diam brs S. 9° E 231 lks. thence S. 35.00 set a cedar post from which an alder 10 ins diam brs N. 43° E 78 lks. thence S 54 1/4° E. 15.42 set post.; thence S. 10.70 set cedar post from which a wh oak 20 ins diam brs S. 57° W 73 lks. thence W. 12.50 thence S. 16.80 to post set for survey N^o

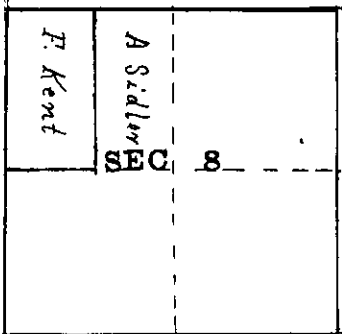

Township 22 South
Range 5 West.

Frank Kent

Oct 17-30, 1899.

SURVEY No. 30

FR 113 PG 36

Begin at the NW cor of sec 8 Twp 22 S R. 5 W. (Var. 20° 15' E). at this cor I set a cedar post and remarked by bearing trees. East from cor. 2.75 top of spur. 9.00 top of descent 19.90 set a fir post (a little S of an old post) from which a fir 36 ins diam brs N. 29° E. 28 lks. Thence South through heavy small fir timber 29.00 top of rise, steep descent 40.00 set post from which a bl. oak 20 ins diam brs N. 48° W. 48 lks. a fir 30 ins diam brs S. 27° W. 49 lks. Thence West - 350 wagon road in gulch ascend E hill side at 20.02 intersect 12 lks N of 1/4 cor. this cor. I reestablish.