


County Surveyor's Record, Douglas County, Oregon

Survey No. 31

Made for *L. W. Kirk*

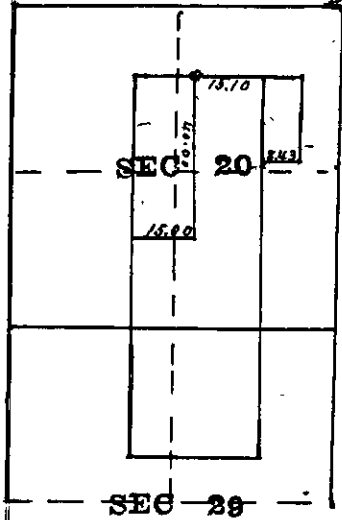

Township 30 South  
Range 5 West.

*Oct. 25-26 '99*

FR 113 PG 37-42

Begin at the exterior cor of the Preston de  
 ation claim on E side of claim in T<sup>h</sup> 30 S R. 5 W. (Cor.  
 20° 10') Run West 843 to interior cor set a river stone 12  
 10x8 for cor old bearing tree down but marks remaining  
 stump. -North- from cor. to river, cor stands in River.

Begin at the W.E. cor of claim 44, set a river stone 14x8x8 for cor  
 at 840 cor falls in River 23.50 set a cedar post for NW. cor  
 of Kirk's land. from which a bl. oak 50 ins diam bro N. 10° W. 129 lbs.  
 (The NW. cor of this stands on gravel bar and is washed away.)

Thence S. through field; 8.50 leave field; ascend 12.65 top; 21.15  
 centre of C Road; 24.00 enter small laurels; 40.00 set bl. oak post, from  
 which a bl. oak 24 ins diam. bro. S. 62 1/2° W. 104 lbs. - Thence - West -  
 descend; 15.00 set bl. oak on claim line. thence S. on W. bearing of claim

30.50 top of outn; 95.10 SW. cor of claim set laurel post and marked  
 a new witness tree: thence E. from cor. along S. hill side, at  
 125<sup>0</sup> enter small prairie 30.21 intersect 8 lbs No of cor.; thence  
 E from cor. 4.75 top of ridge, descend, heavy small timber

Township 25 South  
Range 7 West.

*N. B. Clarke.*

*N. B. Clarke*

*A. H. Churchill  
B. B. Yale*  
SEC 21

*Dec. 15, 1899.*

A. H. Churchill, N. B. Clarke and Geo. B. Yale.

SURVEY No. 36

FR 113 PG 43-44

Begin at the NW. cor. of sec. 21 T<sup>h</sup> 25 S. R. 7 W. (Cor.  
 20° E) South from cor. 4.00 top of spur. 11.50 top of ridge steep descent.  
 20.00 set stone 16x8x6 for cor. did not run line S. to 1/4 post as stands in mill  
 pond. Thence E. from 1/16 cor. 3.16 County road. through pasture 20.00  
 marked a wh. fir for cor. 25.30 S. R. of Hubbard creek. -40.00 set a yew post 50  
 S. of bank of Whopqua. from which a maple 15 ins diam bro. N. 88° W 43 lbs  
 North from NW. cor of sec 21 steep descent on W.E. slope. 12.00 top of hill.  
 20.00 set a cedar post in gulch. from which a fir 24 ins bro. S. 45° E. 38 lbs.  
 Thence East to river edge

*Dec 18, 1899.*