

County Surveyor's Record, Douglas County, Oregon

Survey No. 40

Made for Lee & Cutlacks

Jan 10<sup>th</sup> 1900

T. 22 S. R. 4 W.  
 FB 110 P. 6 1860

Begin at the cor to sec 8, 9, 16 & 17 T. 22 S. R. 4 W. Var. 20° 08' E. this cor I reestablished set a grey post North - ascend hill, 19.00 enter opening 20.00 limb post 36.55 grainfield, 39.89 intersect W of " cor. this cor I reestablished. South on true line 19.95 set wh oak post for 1/4 cor from which a wh oak 10 in diam brs N 32° W 35 lks. West from 1/16 cor 14.00 marked a fir (14.00)

Township 22 South  
 Range 4 West.

Feb. 23-24/00

J. H. Dunbar.

SURVEY No. 42

T. 21 S. R. 5 W.  
 FB 110 P. 6 1860

Begin at the 1/4 sec cor bet sec 31 & 32 T. 21 S. R. 5 W. (Var. 19° 54' E) remarked old bearing tree and set a cedar post, descend hill 670 wagon road 750 stream course E. 10.00 begin steep ascent, 1625 top, 20.00 limb post, 40.90 intersect T. line E of cor. old bearing tree cut down I reestablished this cor set cedar post. - North on true line 20.45 set post for 1/16 cor. from which a fir 10 in diam brs S 8° E. 52 lks.  
 " " 12 " " " S 19° W 26 "


Township 21 South  
 Range 5 West.

Mar 8<sup>th</sup> 1900

Fred Whitbeck

SURVEY No. 43.

T. 25 S.  
 R. 7 W R. 6 W

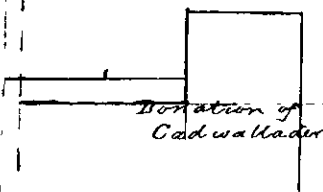

Begin at the N.E. cor of the Cadwallader donation claim No. 37 T. 25 S. R. 6 & 7 W. Run W on North line to cor. thence South <sup>17.10</sup> to a cline, thence West 45.00 no trace of old bearing trees to be found, have been cut down and stumps gouged out, at this point I set a stone 15x8x6 ins for cor to claim from which a bl. oak 7 ins diam brs N 57° W 20 lks.

" " " " " 7 " " " S 66° E. 45. " thence 246 to meanders of Umpqua River.

Feb 11<sup>th</sup> 1900

Begin at the S.E. cor of sec 24 T. 25 S. R. 7 W. (Var 19° 50' E). West from cor. through field 40.20 1/4 sec. cor. this cor I reestablished, set a fir post. Thence North 1/4 cor. 2.00 leave field 5.40 wagon road, 6.35 set post on donation line from which a wh oak 8 ins diam brs N 34° E. 21 lks.

" " " " " 36 " " " N 88° W. 38 " at 25.00 set stone 8x6x4 from which a white oak 30 in diam brs N 10° W. 231 lks. West 20.00 set stone 18x6x6 for cor. from which a fir 18 ins diam brs S 57° W 37 lks.

Township 25 South  
 Range 7 West.