

County Surveyor's Record, Douglas County, Oregon

Survey No. 60

Made for Douglas County

June 19 to 21st 1900

T. 29 S. R. 3 W.
FB 113 P. 6 & 8

Extension of County Road up the South Fork of Myrtle Creek. Beginning at a point 11.66 chms N of 1/4 sec cor bet sec 16 & 21 Twp. 29 S. R. 3 W. Commencement of road I set a cedar post from which a double cedar 8 ins diam brs N 12° E. 3 lks - a fir 20 " " " S. 36° W 86 " Thence in a northeasterly direction up Myrtle Creek to a point 33.70 chms North and 17.50 chms E of the SW cor of sec 2 Twp. 29 S. R. 3 W. Petitioned by Sellers and others. Length of road 3 miles and 28.12 chms.

Township 29 South
Range 3 West.

June 22 1900

SURVEY No. 61
T. 29 S. R. 5 W.
FB 1 - P. 89

J. D. Chaney

Begin at the N.E. cor of the S. Wright donation claim N. 45 Twp. 29 S. R. 5 W. South from cor 13.25 set post in top of ridge for N.E. cor of J. D. Chaney land thence South 26.50 S.E. cor set a cedar post in field. Thence N 30.55 to SW cor.

Township 29 South
Range 5 West.

June 25 & 26 1900


FB 112 P. 6 90-91
SURVEY No. 62.

J. C. McWilliamson and Robt McLaughlin

Begin at the N.E. cor of sec 34 Twp. 27 S. R. 5 W. set fir post (Var 19° E). West from cor. ascending hill 40.60 intersect 1/4 sec cor. set a fir post 41.90 top of hill 60.09 set chittum post near a spring from which a bl. 20 ins diam S 62° W. 54 lks. Begin at the 1/16 cor set 20.30 N of N.E. cor of sec 34 a chittum post from which a willow 6 ins diam brs S. 61° E 40 lks.

- an ash 10 " " " N. 40° W 37 "
North from cor without chaining (Var. 18° 40' E). through sec 27 and 22 to a post set by J. W. Lincoln 2000 N of the N.E. cor of sec 22 intersected 17 lks west of post.

Township 27 South
Range 5 West.

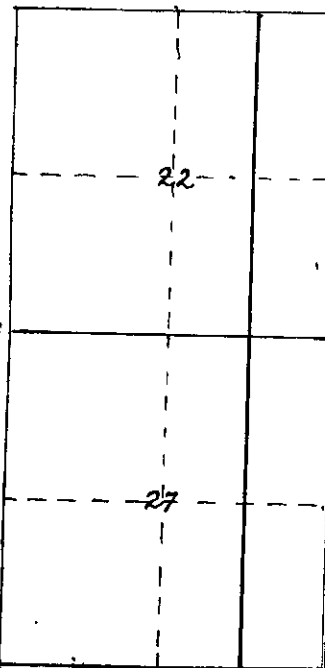

T. 27 S. R. 5 W.