


County Surveyor's Record, Douglas County, Oregon

Survey No. 3

Made for S. Johnson & Hodges

July 13 - 1900

T30 S R 5 W

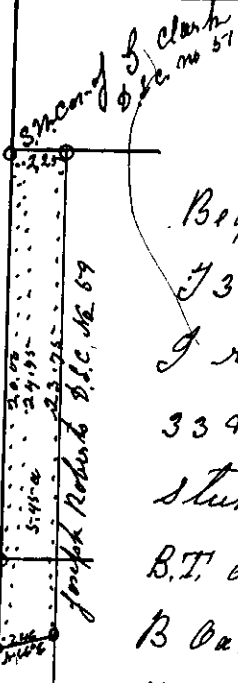

Began at S.W. cor of J. S. Clark D.L.C. No. 51  
T30 S R 5 W - Mar 1900

I run South 20.00 ch to cor to sec 24.29  
33 & 34. The B.T. had all been cut down  
stump standing. Made and marked new

B.T. as per instruction to wit:

- B Oak & in line bears N 18° E 26 1/2
- Hir 8 " " " N 57° W 49 "
- Lawn 6 " " " S 80 1/2° W 55 "
- " 6 " " " S 69 1/2° E 35 "

Continue on South at 24.75 ch set Rock 5x5x10 in center  
of County Road leading from Canyonville to Reddick ore  
Thence N 66° E 2.46 ch along Co Road to West bdy line of  
Joseph Roberts D.L.C. No. 59. set Rock 5x5x10 in in center of  
said Co. Road. Thence North on West bdy line of Cl 59,  
23.75 ch to N.W. cor. of said claim 59, and Thence West  
2.25 ch to place of begin. Cont 6.40 acres

Jasper Johnson & H. Hodges }  
Sewer Chaimmen }  
W. F. Briggs  
Co Surveyor

July 17 - 1900

H. J. Wilson Administrator of Estate of Sewer

Part of T32 S R 5 W

